

MISSISSIPPI DEPARTMENT OF NATURAL RESOURCES

Bureau of Land and Water Resources

Southport Mall

P.O. Box 10631

Jackson, Mississippi 39209

WATER WELL DRILLERS LOG

Washington
E 2019

4-16 1982 Schultz Drilling Washington
date well completed firm name county well located

LANDOWNER: <u>US DSA</u> <u>Stoneville, MS</u> (mailing address)	description of formations encountered	from	to
	<u>SANDY topsoil</u>	<u>0</u>	<u>15</u>
	<u>SAND + pea gravel</u>	<u>15</u>	<u>80</u>
WELL LOCATION: sec. <u>2</u> T. <u>18</u> N. R. <u>7</u> E. <u>1</u> miles <u>N</u> of <u>Stoneville</u> (distance) (direction) (nearest town)			
WELL PURPOSE: <u>IRRIGATION</u> (home, irrigation, municipal, industrial)			
WELL COMPLETION DATA:			
(1) diameter (inches) <u>2"</u>			
(2) total depth (feet) <u>80'</u>			
(3) static water level (feet) <u>15'</u> <u>below</u> above top of ground.			
(4) casing <u>PVC</u> , <u>70'</u> (material) (depth) (size) if telescope see back.			
(5) screen <u>10'</u> , <u>70'</u> (length) (depth to top) <u>2"</u> , <u>PVC</u> (size) (material)			
(6) pump <u>X</u> , <u>X</u> (HP) (yield gpm) <u>X</u> (type power)			
(7) electric log <u>NO</u> (yes or no) (organization running log)			
(8) how well bottom plugged <u>cap/PVC</u>			
DRILLERS REMARKS:			


DEPT. OF NATURAL RESOURCES
BUREAU OF LAND & WATER RESOURCES

MAY 14 1982

RECEIVED

If well telescopes please
sketch and show depths.

GROUND LEVEL

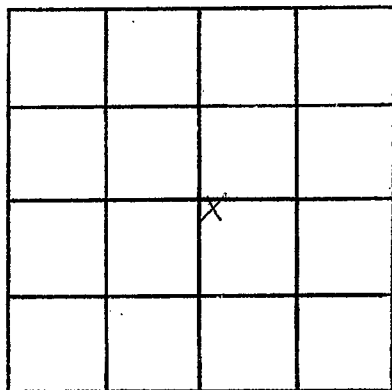

SECTION _____

Please indicate well location X.

ADDITIONAL INFORMATION

If more than one screen,
show locations of each on sketch.