

MISSISSIPPI DEPARTMENT OF NATURAL RESOURCES

Bureau of Land and Water Resources

Southport Mall

P.O. Box 10631

Jackson, Mississippi 39209

WATER WELL DRILLERS LOG

Washington
E
2221

22 Nov 1982 Kambert Drilling Wash
 date well completed firm name county well located

LANDOWNER:	description of formations encountered	from	to
(mailing address)			
<u>Allan Probst, ridge</u> <u>Greenville, Miss.</u>	<u>Clay</u>	<u>0</u>	<u>30</u>
WELL LOCATION: sec. <u>27</u> T. <u>18</u> N. R. <u>7</u> E. W. <u>8</u> <u>3</u> miles <u>E</u> of <u>Greenville</u> (distance) (direction) (nearest town)	<u>Sand</u>	<u>30</u>	<u>60</u>
WELL PURPOSE: <u>none.</u> (home, irrigation, municipal, industrial)	<u>pea gravel</u>	<u>60</u>	<u>82</u>
WELL COMPLETION DATA:	<u>Clay</u>	<u>82</u>	<u>190</u>
(1) diameter (inches) <u>4x2</u>	<u>Rock</u>	<u>190</u>	<u>196</u>
(2) total depth (feet) <u>476</u>	<u>Clay st sand</u>	<u>196</u>	<u>400</u>
(3) static water level (feet) <u>43</u> below above top of ground.	<u>sand</u>	<u>400</u>	<u>470</u>
(4) casing <u>PVC</u> , <u>450</u> , (material) (depth) <u>4x2</u> if telescope see back. (size)			
(5) screen <u>20</u> , <u>470-450</u> (length) (depth to top)			
(6) pump <u>2</u> , <u>PVC</u> , (HP) (yield gpm) <u>elect</u> (type power)			
(7) electric log <u>no</u> (yes or no) (organization running log)			
(8) how well bottom plugged <u>6 inch PVC</u>			
DRILLERS REMARKS:			

DEPT. OF NATURAL RESOURCES
 BUREAU OF LAND & WATER RESOURCES

MAR 22 1984

RECEIVED


If well telescopes please sketch and show depths.

GROUND LEVEL

140 4"

450 2"

470 2" 80v.

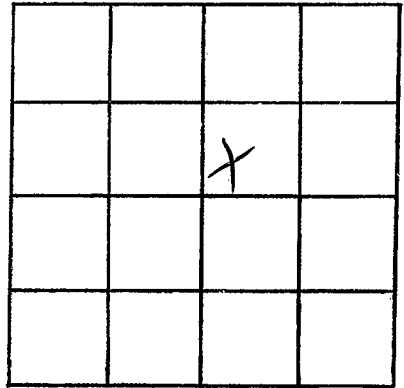

SECTION 27

Please indicate well location X.

ADDITIONAL INFORMATION

If more than one screen,
show locations of each on sketch.