

MISSISSIPPI DEPARTMENT OF NATURAL RESOURCES

Bureau of Land and Water Resources

Southport Mall

P.O. Box 10631

Jackson, Mississippi 39209

WATER WELL DRILLERS LOG

Washington
E 2022

11 June 1984
date well completed

Lambert Drilling
firm name

Wash
county well located

LANDOWNER:	description of formations encountered	from	to
Emmett McKnight, Iceland, MISS. (mailing address)			
WELL LOCATION:	Sand	30	60
sec. <u>32</u> T. <u>18</u> N. R. <u>7</u> E. W.	fine gravel	60	75
<u>5</u> miles <u>S/W</u> of <u>Iceland</u> (distance) (direction) (nearest town)	blue shell	75	180
WELL PURPOSE: <u>none</u> (home, irrigation, municipal, industrial)	Clay	180	220
WELL COMPLETION DATA:	rock	220	221
(1) diameter (inches) <u>4x2</u>	Clay st sand	221	260
(2) total depth (feet) <u>450</u>	Sand good	260	335
(3) static water level (feet) <u>32</u> below above top of ground.	rock	335	336
(4) casing <u>PVC</u> <u>420</u> (material) (depth)	Clay st sand	336	390
<u>4x2</u> If telescope see back. (size)	Sand good	390	450
(5) screen <u>30</u> <u>450-430</u> (length) (depth to top)			
<u>2</u> <u>PVC</u> (size) (material)			
(6) pump <u>1</u> <u>20</u> (HP) (yield gpm)			
<u>elect</u> (type power)			
(7) electric log (yes or no)			
(organization running log)			
(8) how well bottom plugged <u>back press.</u>			
DRILLERS REMARKS:			

DEPT. OF NATURAL RESOURCES
BUREAU OF LAND & WATER RESOURCES

AUG 15 1984

RECEIVED


If well telescopes please sketch and show depths.

GROUND LEVEL

140 4"

420 2"

430 2" 50v

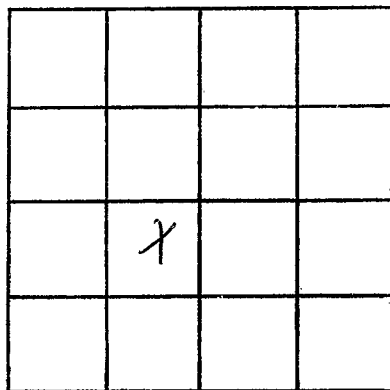

SECTION 32

Please indicate well location X.

ADDITIONAL INFORMATION

If more than one screen, show locations of each on sketch.