

MISSISSIPPI DEPARTMENT OF NATURAL RESOURCES

Bureau of Land and Water Resources

Southport Mall

P.O. Box 10631

Jackson, Mississippi 39209

WATER WELL DRILLERS LOG

Washington
E 2023

9-1 1984
date well completed

Schultz Drilling
firm name

Washington
county well located

LANDOWNER: Melba Rushing
Black Bayou Rd
Greenville, MS
(mailing address)

description of formations encountered

from

to

CLAY	0	20
SAND + gravel	20	90
CLAY	90	280
Shale	280	400
SAND	400	460

WELL LOCATION:

sec. 19 T. 18 N. R. 7 E
2 miles E of Greenville
(distance) (direction) (nearest town)

WELL PURPOSE: HOME
(home, irrigation, municipal, industrial)

WELL COMPLETION DATA:

- (1) diameter (inches) 2"
- (2) total depth (feet) 460'
- (3) static water level (feet) 36' below top of ground.
- (4) casing PVC 450'
(material) (depth)

(size) if telescope see back.

- (5) screen 10' 450'
(length) (depth to top)

2" PVC
(size) (material)

- (6) pump 1 10
(HP) (yield gpm)

ele
(type power)

- (7) electric log NO
(yes or no)

K
(organization running log)

- (8) how well bottom plugged b/w


DRILLERS REMARKS:

MISSISSIPPI DEPARTMENT OF NATURAL RESOURCES
BUREAU OF LAND & WATER RESOURCES

OCT - 9 1984
RECEIVED

If well telescopes please sketch and show depths.

GROUND LEVEL

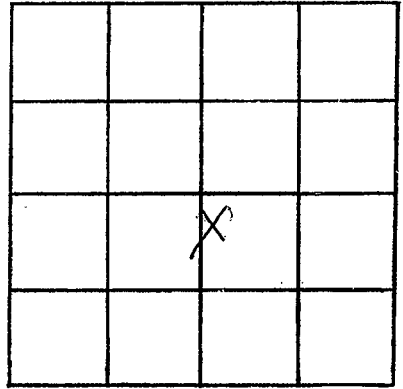

SECTION 19

Please indicate well location X.

ADDITIONAL INFORMATION

If more than one screen,
show locations of each on sketch.