

MISSISSIPPI DEPARTMENT OF NATURAL RESOURCES

Bureau of Land and Water Resources

Southport Mall

P.O. Box 10631

Jackson, Mississippi 39209

WATER WELL DRILLERS LOG

Washington
E 2024

Aug 19 1985 date well completed
Larry's well & pump firm name
Washington county well located

LANDOWNER: <u>Larry Frasier</u>	description of formations encountered	from	to
<u>Greenville, Mo</u> (mailing address)	<u>Sand</u>	<u>420</u>	<u>540</u>
WELL LOCATION: sec. <u>19</u> T. <u>18</u> N. S. R. <u>7</u> E. <u>GP</u> <u>2</u> miles <u>E</u> of <u>Greenville</u> (distance) (direction) (nearest town)			
WELL PURPOSE: (home, irrigation, municipal, industrial)			
WELL COMPLETION DATA:			
(1) diameter (inches) <u>4" x 2"</u>			
(2) total depth (feet) <u>540</u>			
(3) static water level (feet) <u>20</u> below above top of ground.			
(4) casing <u>PVC</u> , <u>500</u> , (material) (depth)			
<u>4x2</u> if telescope see back. (size)			
(5) screen <u>40</u> , <u>500 to 540</u> (length) (depth to top)			
<u>2'</u> , <u>PVC</u> (size) (material)			
(6) pump <u>1</u> , <u>20</u> (HP) (yield gpm)			
<u>220</u> etc. (type power)			
(7) electric log <u>no</u> (yes or no) (organization running log)			
(8) how well bottom plugged <u>Shack</u>			
DRILLERS REMARKS:			

RECEIVED

MAY 11 1987

Department of Natural Resources
Bureau of Land & Water Resources


If well telescopes please sketch and show depths.

GROUND LEVEL

120' 4" PVC

380' 2" PVC

40' 2" PVC
screen

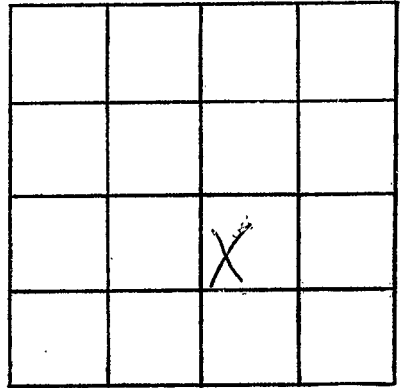

SECTION 19

Please indicate well location X.

ADDITIONAL INFORMATION

If more than one screen, show locations of each on sketch.