

MISSISSIPPI DEPARTMENT OF NATURAL RESOURCES

Bureau of Land and Water Resources

Southport Mall

P.O. Box 10631

Jackson, Mississippi 39209

WATER WELL DRILLERS LOG

|            |
|------------|
| WASHINGTON |
| 2005       |
|            |
|            |

4-10 1985 Schultz Drilling Washington  
 date well completed firm name county well located


| LANDOWNER:  | description of formations encountered | from | to |
|---|---------------------------------------|------|----|
| Billy Johnson<br>Leland MS<br>(mailing address)   |                                       |      |    |
| WELL LOCATION:<br>sec 24 T 18 N R 7 E<br>2 miles E of Leland<br>(distance) (direction) (nearest town) |                                       |      |    |
| WELL PURPOSE: IRRIGATION<br>(home, irrigation, municipal, industrial)                                 |                                       |      |    |
| WELL COMPLETION DATA:   |                                       |      |    |
| (1) diameter (inches) 4"  |                                       |      |    |
| (2) total depth (feet) 100'   |                                       |      |    |
| (3) static water level (feet) 28' below top of ground.  |                                       |      |    |
| (4) casing PVC, 80' (material) (depth)  |                                       |      |    |
| (5) screen 10' 80' (length) (depth to top)<br>4" PVC (size) (material)                                |                                       |      |    |
| (6) pump 1 (HP) 20 (yield gpm)<br>ele (type power)  |                                       |      |    |
| (7) electric log NO (yes or no)<br>X (organization running log)                                       |                                       |      |    |
| (8) how well bottom plugged CAP   |                                       |      |    |
| DRILLERS REMARKS:   |                                       |      |    |

RECEIVED  
 DEC 3 - 1985

of Natural Resources  
 Bureau of Land & Water Resources

If well telescopes please sketch and show depths.

GROUND LEVEL

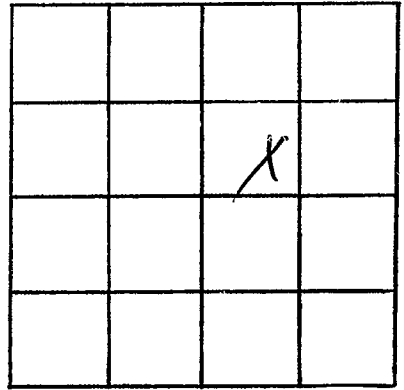

SECTION 24

Please indicate well location X.

ADDITIONAL INFORMATION

If more than one screen,  
show locations of each on sketch.