

MISSISSIPPI DEPARTMENT OF NATURAL RESOURCES

Bureau of Land and Water Resources

Southport Mall

P.O. Box 10631

Jackson, Mississippi 39209

WATER WELL DRILLERS LOG


WASHINGTON
E 2020

7-16 1985 Schultz Drilling WASHINGTON
date well completed firm name county well located

LANDOWNER: MACK Frates,
St. Christopher Rd
Greenville MS
(mailing address)

description of formations encountered	from	to
CLAY	0	18
SAND	18	75

WELL LOCATION:
sec. 11 T. 18 N. R. 7 E
3 miles W of Leland
(distance) (direction) (nearest town)

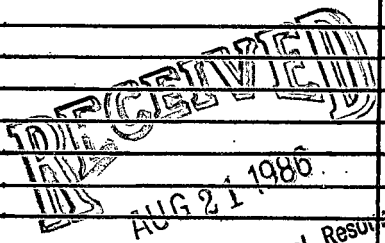

WELL PURPOSE: IRRIGATION
(home, irrigation, municipal, industrial)


- WELL COMPLETION DATA:
- (1) diameter (inches) 2"
 - (2) total depth (feet) 75'
 - (3) static water level (feet) 20' below top of ground.
 - (4) casing PUC 65' (material) (depth)
 - (5) screen 10' 65' (length) (depth to top)
2" (size) PUC (material)
 - (6) pump 20 gpm (yield gpm)
(HP) (type power)
 - (7) electric log No (yes or no)
X (organization running log)
 - (8) how well bottom plugged CAP

Department of Natural Resources
Bureau of Land & Water Resources

DRILLERS REMARKS:

If well telescopes please sketch and show depths.

GROUND LEVEL

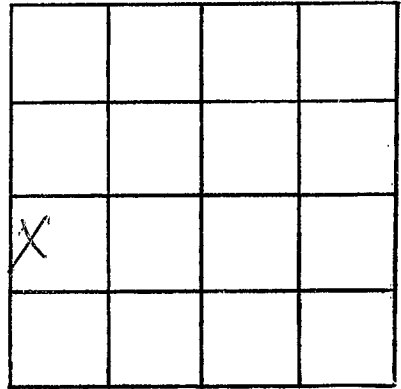

SECTION 19

Please indicate well location X.

ADDITIONAL INFORMATION

If more than one screen,
show locations of each on sketch.