

MISSISSIPPI DEPARTMENT OF NATURAL RESOURCES

Bureau of Land and Water Resources

Southport Mall

P.O. Box 10631

Jackson, Mississippi 39209

WATER WELL DRILLERS LOG

WASHINGTON
E0027

4-12-86 date well completed Schultz Drilling firm name Washington county well located

LANDOWNER:
Billy Boone
Leland MS
(mailing address)

description of formations encountered	from	to
	Topsoil CLAY	0
SAND	10	30
COARSE SAND and PEA GRAVEL	30	80

WELL LOCATION:
sec. 14 T-18 S R-7 E
1/4 miles E of Leland
(distance) (direction) (nearest town)

WELL PURPOSE: IRRIGATION
(home, irrigation, municipal, industrial)

WELL COMPLETION DATA:

- (1) diameter (inches) 4"
- (2) total depth (feet) 80'
- (3) static water level (feet) 23' below top of ground.
- (4) casing PVC, 60' (material) (depth)
- (size) if telescope see back.
- (5) screen 20' 60' (length) (depth to top)
- 4" PVC (size) (material)
- (6) pump 2 40 (HP) (yield gpm)
- Generator (type power)
- (7) electric log NO (yes or no)
- K (organization running log)
- (8) how well bottom plugged CAP.


DRILLERS REMARKS:

RECEIVED
MAY 21 1986

Department of Natural Resources
BUREAU OF LAND & WATER

If well telescopes please sketch and show depths.

GROUND LEVEL

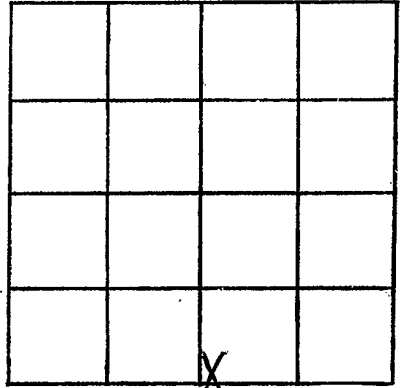

SECTION 14

Please indicate well location X.

ADDITIONAL INFORMATION

If more than one screen,
show locations of each on sketch.