

MISSISSIPPI DEPARTMENT OF NATURAL RESOURCES

Bureau of Land and Water Resources

Southport Mall

P.O. Box 10631

Jackson, Mississippi 39209

WATER WELL DRILLERS LOG

WASHINGTON
E
2008

6-13-86, date well completed

Scholtz Drilling firm name

WASHINGTON county well located

LANDOWNER: Steve Hicks

Hwy 82

Greenville, MS (mailing address)

WELL LOCATION:

sec. 18 T. 18 N. R. 7 E. 2 miles W of Leland (distance) (direction) (nearest town)

WELL PURPOSE: home (home, irrigation, municipal, industrial)

WELL COMPLETION DATA:


- (1) diameter (inches) 2"
- (2) total depth (feet) 450'
- (3) static water level (feet) 30' below top of ground.
- (4) casing PVC, 430' (material), (depth)
- (5) screen 20' 430' (length), (depth to top) 2" PVC (size), (material)
- (6) pump 2 15 (HP), (yield gpm) el (type power)
- (7) electric log NO (yes or no) X (organization running log)
- (8) how well bottom plugged b/w

description of formations encountered

from

to


CLAY	0	30
SAND	30	80
CLAY	80	285
MED. SAND	285	390
GOOD SAND.	390	450

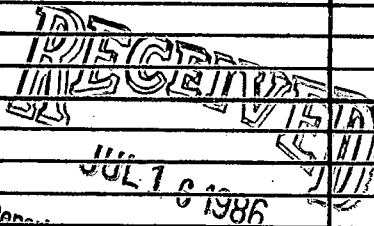

DRILLERS REMARKS:

If well telescopes please sketch and show depths.

GROUND LEVEL

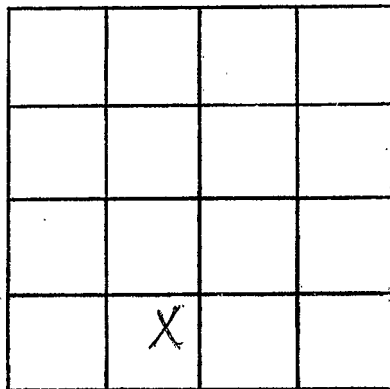

SECTION 18

Please indicate well location X.

ADDITIONAL INFORMATION

If more than one screen, show locations of each on sketch.