

WASHINGTON
E 2009

MISSISSIPPI DEPARTMENT OF NATURAL RESOURCES

Bureau of Land and Water Resources

Southport Mall

P.O. Box 10631

Jackson, Mississippi 39209

WATER WELL DRILLERS LOG

9-18-86 Schultz Drilling Washington

date well completed

firm name

county well located

LANDOWNER: Bill EVANS
Delta Village PK
Greenville MS
(mailing address)

description of formations encountered

from

to

CLAY	0	15
SAND + GRAVEL	15	150
SHALE	150	380
SAND.	380	430 430

WELL LOCATION:

sec. 28 T 18 N R. 7 E
3 miles SW of Leland
(distance) (direction) (nearest town)

WELL PURPOSE: HOME
(home, irrigation, municipal, industrial)

WELL COMPLETION DATA:

- (1) diameter (inches) 4" X 2"
- (2) total depth (feet) 430'
- (3) static water level (feet) 31' ^{below} / _{above} top of ground.
- (4) casing PVC 410'
(material) (depth)

if telescope see back.
(size)

- (5) screen 20' 410'
(length) (depth to top)
2" PVC
(size) (material)

- (6) pump 1 20
(HP) (yield gpm)
elc
(type power)

- (7) electric log X
(yes or no)
X
(organization running log)

- (8) how well bottom plugged b/w

RECEIVED
OCT 01 1986

Department of Natural Resources
Bureau of Land & Water Resources

DRILLERS REMARKS:


If well telescopes please sketch and show depths.

GROUND LEVEL

120'
4"
PVC
CASING

290'
2"
PVC
CASING

20'
2"
PVC
Screen

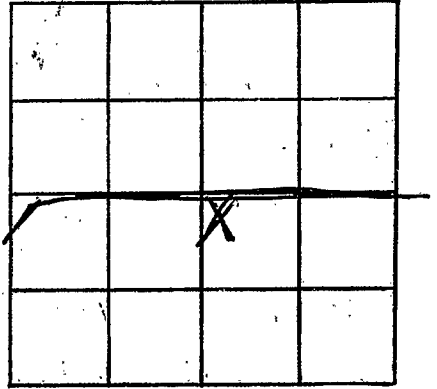

SECTION 28

Please indicate well location X.

ADDITIONAL INFORMATION

If more than one screen, show locations of each on sketch.