

MISSISSIPPI DEPARTMENT OF NATURAL RESOURCES

Bureau of Land and Water Resources

Southport Mall

P.O. Box 10631

Jackson, Mississippi 39209

WATER WELL DRILLERS LOG

WASHINGTON  
E 2031

12-5 1986 Schultz Drilling Washington  
date well completed firm name county well located

LANDOWNER: Sue Oliver  
Glendale Rd  
Greenville, MS  
(mailing address)

description of formations encountered

from to

CLAY	0	30
COARSE SAND	30	90
CLAY	90	135
SHALE	135	360
SAND	360	405

WELL LOCATION:

sec 19 T 18 N R 7 E  
3 miles E of Greenville  
(distance) (direction) (nearest town)

WELL PURPOSE: Home  
(home, irrigation, municipal, industrial)

WELL COMPLETION DATA:

- (1) diameter (inches) 2"
- (2) total depth (feet) 405'
- (3) static water level (feet) 31' below top of ground.
- (4) casing PVC 395' (material) (depth)  
2" (size) if telescope see back.
- (5) screen 10' 395' (length) (depth to top)  
2" (size) PVC (material)
- (6) pump 1 10 (HP) (yield gpm)  
F/E (type power)
- (7) electric log No (yes or no)  
(organization running log) b/w
- (8) how well bottom plugged b/w

RECEIVED


FEB 06 1987

Department of Natural Resources  
Bureau of Land & Water Resources

DRILLERS REMARKS:

If well telescopes please  
sketch and show depths.

GROUND LEVEL

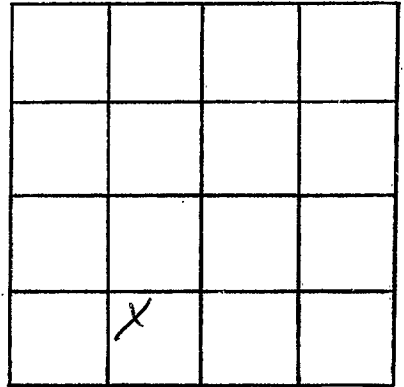

SECTION 19

Please indicate well location X.

ADDITIONAL INFORMATION

If more than one screen,  
show locations of each on sketch.