

WASHINGTON
E 0035

MISSISSIPPI DEPARTMENT OF NATURAL RESOURCES
 Bureau of Land and Water Resources
 Southport Mall
 P.O. Box 10631
 Jackson, Mississippi 39209
WATER WELL DRILLERS LOG

10-1 87
 date well completed

firm name

county well located

Schultz Drilling Washington

LANDOWNER: 4-PLAY Recreation

description of formations encountered

from

to

St. Christopher Rd

Greenwell MS

(mailing address)

CLAY
 SAND
 CLAY
 SAND

0 20
 20 80
 80 360
 360 420

WELL LOCATION:

sec. 11 T. 18 N. R. 2 E
2 miles (distance) E (direction) of Greenwell (nearest town)

WELL PURPOSE: HOME
 (home, irrigation, municipal, industrial)

WELL COMPLETION DATA:

- (1) diameter (inches) 2"
- (2) total depth (feet) 420'
- (3) static water level (feet) 35' ~~below~~ above top of ground.
- (4) casing PVC 410'
 (material) (depth)

 if telescope see back.
 (size)

- (5) screen 10' 410'
 (length) (depth to top)
2" PVC
 (size) (material)

- (6) pump 1 10
 (HP) (yield gpm)
ele
 (type power)

- (7) electric log NO
 (yes or no)
X
 (organization running log)

- (8) how well bottom plugged b/w

RECEIVED


OCT 28 1987

Department of Natural Resources
 Bureau of Land & Water Resources

DRILLERS REMARKS:

If well telescopes please sketch and show depths.

GROUND LEVEL

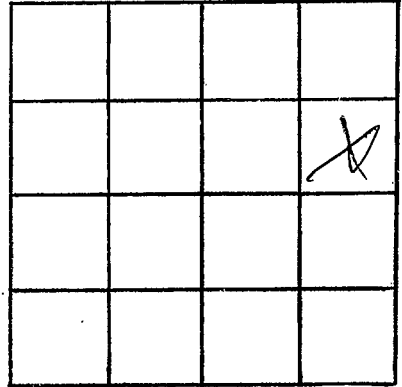

SECTION 19

Please indicate well location X.

ADDITIONAL INFORMATION

If more than one screen, show locations of each on sketch.