

MISSISSIPPI DEPARTMENT OF NATURAL RESOURCES

Bureau of Land and Water Resources

Southport Mall

P.O. Box 10631

Jackson, Mississippi 39209

WATER WELL DRILLERS LOG

26 May 1987
date well completed

87 Lambert Drilling
firm name

Wash
county well located

LANDOWNER:	description of formations encountered	from	to
BFI			
Greenville, Miss. (mailing address)	Clay	0	30
WELL LOCATION:	Sand	30	60
sec. 17 T. 15 N. R. 7 E 8 W	fine gravel	60	82
5 miles E of Greenville (distance) (direction) (nearest town)	blue shell	82	190
WELL PURPOSE: <i>Industrial</i> (home, irrigation, municipal, industrial)	Clay sand sh	190	280
WELL COMPLETION DATA:	Sand fine	280	410
(1) diameter (inches) 4x2	Sand	410	480
(2) total depth (feet) 480			
(3) static water level (feet) 51 below above top of ground.			
(4) casing PVC 406 (material) (depth) 4x2 (size) if telescope see back.			
(5) screen 30 480-456 (length) (depth to top) 2' PVC (size) (material)			
(6) pump 1/2 30 (HP) (yield gpm) elect (type power)			
(7) electric log (yes or no) (organization running log)			
(8) how well bottom plugged back pass			
DRILLERS REMARKS:			

RECEIVED

OCT 29 1987

Department of Natural Resources
Bureau of Land & Water Resources


If well telescopes please sketch and show depths.

GROUND LEVEL

140 4"

450 2"

480 2" 5d1

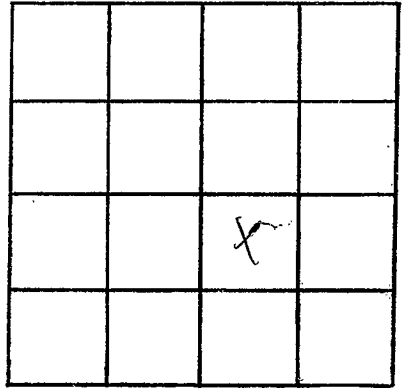

SECTION 17

Please indicate well location X.

ADDITIONAL INFORMATION

If more than one screen,
show locations of each on sketch.