

WASHINGTON
E 2038

MISSISSIPPI DEPARTMENT OF NATURAL RESOURCES
Bureau of Land and Water Resources
Southport Mall
P.O. Box 10631
Jackson, Mississippi 39209
WATER WELL DRILLERS LOG

16 June 1987 Lambert Drilling Wash
date well completed firm name county well located

LANDOWNER:	description of formations encountered	from	to
Doan Wright Leland, Miss. (mailing address)			
WELL LOCATION: sec. 22 T. 18 N. R. 7 E 1 miles S of Leland (distance) (direction) (nearest town)	Clay	15	35
WELL PURPOSE: none (home, irrigation, municipal, industrial)	Sand & gravel	35	110
WELL COMPLETION DATA:	Clay	110	230
(1) diameter (inches) 4x2	Clayst sand	230	395
(2) total depth (feet) 465	Sand	395	465
(3) static water level (feet) 48 below top of ground.			
(4) casing PVC, 435 (material) (depth) 4x2 if telescope see back. (size)			
(5) screen 30, 405-435 (length) (depth to top) 2" PVC (size) (material)			
(6) pump 1, 20 (HP) (yield gpm) elect (type power)			
(7) electric log no (yes or no) (organization running log)			
(8) how well bottom plugged backflow.			
DRILLERS REMARKS:			

RECEIVED

NOV 25 1987

Department of Natural Resources
Bureau of Land & Water Resources

If well telescopes please sketch and show depths.

GROUND LEVEL

140


4"

435

2"

465

2" scr.

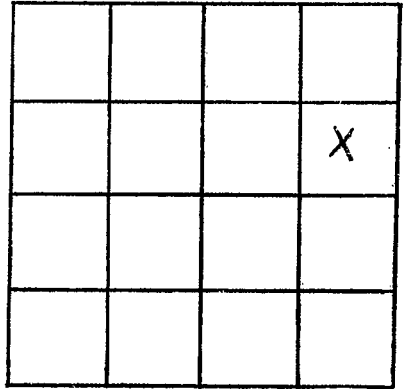

SECTION 22

Please indicate well location X.

ADDITIONAL INFORMATION

If more than one screen, show locations of each on sketch.