

**MISSISSIPPI DEPARTMENT OF ENVIRONMENTAL QUALITY**

Office of Land and Water Resources

P. O. Box 10631  
Jackson, MS 39289-0631  
**WATER WELL DRILLERS LOG**

COUNTY WELL LOCATED <u>Washington</u>	
WELL NUMBER <u>E</u>	CODED
DATE WELL COMPLETED <u>3-14-94</u>	

PERMIT NUMBER
NAME OF DRILLING FIRM <u>Schudco Ltd</u>

NAME & MAILING ADDRESS OF LANDOWNER <u>Gordon Tupper</u>		
<u>Greenville Ms</u>		
<u>38701</u>		
WELL LOCATION: SEC	TOWNSHIP	RANGE
<u>8</u>	<u>18</u> <sup>N</sup> / <sub>S</sub>	<u>7</u> <sup>E</sup> / <sub>W</sub>
DISTANCE	DIRECTION	NEAREST TOWN
<u>2</u> Miles	<u>NW</u>	of <u>Leland</u>
OTHER LANDMARK		
WELL PURPOSE <u>Home</u> Irrigation, Municipal, Industrial, Fish Pond, etc.		

PUMP DATA		
PUMP TYPE (Circle One): <u>Submersible</u> , Turbine, Jet, Flowing Well, Other (Describe) _____		
POWER TYPE (Circle One): <u>Electric</u> , Tractor, Diesel, Gasoline, Butane, Other (Describe) _____ H/P _____		
Pump Capacity (GPM)	No. of Stages	Setting Depth
		FT.
PUMP TEST		
Well yielded _____ GPM with a drawdown of _____ ft. after _____ hours of pumping		

WELL DATA		
Well Depth <u>500</u>	Casing Diameter (in.) <u>4x2</u>	Casing Length (ft.) <u>460</u>
Type of Casing <u>PVC</u>	Hole Depth <u>508</u>	Depth to Static Water Level <u>32</u>
TYPE OF COMPLETION: (Circle One or More): <u>Natural Development</u> , Underreamed, Telescoped, Open Hole, Other		

LOG DATA	
TYPE OF LOG RUN (Circle One): Electric, Gamma Ray, Density, Sonic, Neutron, Other (Describe) _____	
Name of Organization Running Log	

WELL GROUTED TO A DEPTH OF <u>10</u> FEET Type Grout (circle one): <u>Cement</u> , Bentonite, or Mix
---

GEOLOGIC DATA (Office Use Only)			
Surface Elev.	Geologic Unit	Unit Thickness	Depth to Top
Subs. SWL	Date	Analysis	Aquifer Test

SCREEN DATA		
Diameter - Inches <u>2</u>	Length - Feet <u>40</u>	Slot Size - Inches <u>1010</u>
Screen Type <u>PVC</u>	Depth to Bottom - Feet <u>500</u>	


Driller's Remarks

DESCRIPTION OF FORMATIONS ENCOUNTERED	FROM	TO	FORMATIONS (Continued)	FROM	TO
<u>Top soil</u>	<u>0</u>	<u>17</u>	<div style="border: 2px solid black; padding: 10px; display: inline-block;"> <b>RECEIVED</b>  <b>AUG 16 1994</b> </div>		
<u>sand + gravel</u>	<u>17</u>	<u>156</u>			
<u>clay + shell</u>	<u>156</u>	<u>427</u>			
<u>sand</u>	<u>427</u>	<u>500</u>			
<u>clay</u>	<u>500</u>	<u>508</u>			

IF MORE SPACE IS NEEDED, USE BACK

If well telescopes please sketch and show depths.

GROUND LEVEL

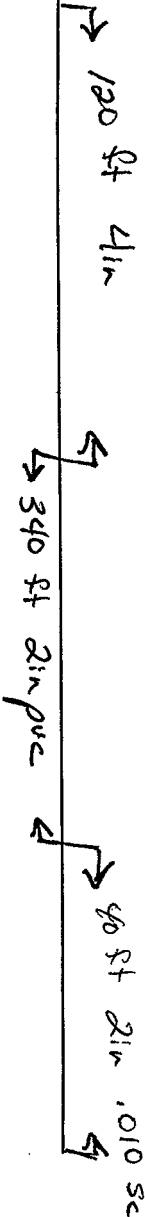

			X

SECTION 8

Please indicate well location X.

ADDITIONAL INFORMATION

---

---

If more than one screen, show location of each on sketch.