

MISSISSIPPI DEPARTMENT OF ENVIRONMENTAL QUALITY

Office of Land and Water Resources

P. O. Box 10631
Jackson, MS 39289-0631
WATER WELL DRILLERS LOG

COUNTY WELL LOCATED <u>Washington</u>	
WELL NUMBER <u>E</u>	CODED
DATE WELL COMPLETED <u>12-7-94</u>	

PERMIT NUMBER
NAME OF DRILLING FIRM <u>Schedco</u>

NAME & MAILING ADDRESS OF LANDOWNER <u>Sammy Strong</u> <u>Leland MS 38756</u>		
WELL LOCATION: SEC <u>8</u> TOWNSHIP <u>18</u> RANGE <u>7</u>	<u>N</u> S	<u>E</u> W
DISTANCE <u>2</u> Miles	DIRECTION <u>NW</u>	NEAREST TOWN <u>Leland</u>
OTHER LANDMARK		
WELL PURPOSE: <input checked="" type="checkbox"/> Home Irrigation, <input type="checkbox"/> Municipal, <input type="checkbox"/> Industrial, <input type="checkbox"/> Fish Pond, etc.		

PUMP DATA		
PUMP TYPE (Circle One): <input checked="" type="checkbox"/> Submersible, <input type="checkbox"/> Turbine, <input type="checkbox"/> Jet, <input type="checkbox"/> Flowing Well, Other (Describe) _____		
POWER TYPE (Circle One): <input checked="" type="checkbox"/> Electric, <input type="checkbox"/> Tractor, <input type="checkbox"/> Diesel, <input type="checkbox"/> Gasoline, <input type="checkbox"/> Butane, Other (Describe) _____ H/P <u>1/2</u>		
Pump Capacity (GPM) <u>7</u>	No. of Stages	Setting Depth <u>80</u> FT.
PUMP TEST		
Well yielded _____ GPM with a drawdown of _____ ft. after _____ hours of pumping		

WELL DATA		
Well Depth <u>480</u>	Casing Diameter (In.) <u>3 X 2</u>	Casing Length (Ft.) <u>460</u>
Type of Casing <u>PVC</u>	Hole Depth <u>480</u>	Depth to Static Water Level <u>32</u>
TYPE OF COMPLETION: (Circle One or More): <input checked="" type="checkbox"/> Gravel Packed, <input type="checkbox"/> Underreamed, <input type="checkbox"/> Telescoped, <input checked="" type="checkbox"/> Natural Development, <input type="checkbox"/> Open Hole, <input type="checkbox"/> Other (Describe) _____		

LOG DATA	
TYPE OF LOG RUN (Circle One): <input checked="" type="checkbox"/> No Log Run, Electric, Gamma Ray, Density, Sonic, Neutron, Other (Describe) _____	
Name of Organization Running Log	

WELL GROUTED TO A DEPTH OF <u>10</u> FEET Type Grout (circle one): Cement, Bentonite, or Mix

GEOLOGIC DATA (Office Use Only)			
Surface Elev.	Geologic Unit	Unit Thickness	Depth to Top
Subs. SWL	Date	Analysis	Aquifer Test

SCREEN DATA		
Diameter - Inches <u>2</u>	Length - Feet <u>20</u>	Slot Size - Inches <u>1,008</u>
Screen Type <u>PVC</u>	Depth to Bottom - Feet <u>480</u>	


Driller's Remarks

DESCRIPTION OF FORMATIONS ENCOUNTERED	FROM	TO	FORMATIONS (Continued)	FROM	TO
<u>clay</u>	<u>0</u>	<u>44</u>	<div style="border: 2px solid black; padding: 10px; display: inline-block;"> RECEIVED JAN 11 1995 Dept. of Environmental Quality Office of Land & Water Resources </div>		
<u>sand & gravel</u>	<u>44</u>	<u>140</u>			
<u>clay</u>	<u>140</u>	<u>440</u>			
<u>sand</u>	<u>440</u>	<u>480</u>			

IF MORE SPACE IS NEEDED, USE BACK

If well telescopes please sketch and show depths.

GROUND LEVEL

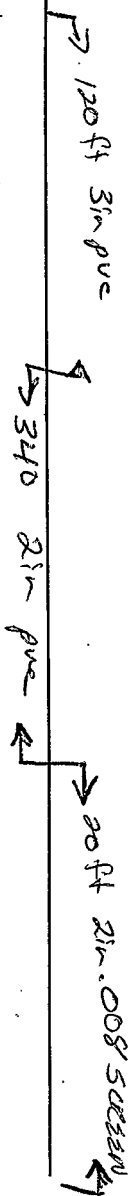

		X	

SECTION 8

Please indicate well location X.

ADDITIONAL INFORMATION

If more than one screen, show location of each on sketch.