

Washington
F34
 7-67

MISSISSIPPI
 BOARD OF WATER COMMISSIONERS
 416 North State Street
 Jackson, Mississippi 39201

WATER WELL DRILLERS LOG

July 14 1967 Schultz Drilling Washington
 date well completed firm name county well located
 0193


LANDOWNER: A. O. Dilley
P.O. Box 26
Peland, Miss.
 (mailing address)

WELL LOCATION:
 sec. 20 T-18 N R-6 E
2 miles E of Peland
 (distance) (direction) (nearest town)

WELL PURPOSE: Home
 (home, irrigation, municipal, industrial)

- WELL COMPLETION DATA:
- (1) diameter (inches) 2"
 - (2) total depth (feet) 556'
 - (3) static water level (feet) 22 below top of ground.
 - (4) casing Steel, 5 1/2
 (material) (depth)
 - if telescope see back.
 (size)
 - (5) screen 10ft.,
 (length) (depth to top)
 - 2", Stainless Steel
 (size) (material)
 - (6) pump 1, 10 gpm
 (HP) (yield gpm)
 - Elec
 (type power)
 - (7) electric log No
 (yes or no)
 - (organization running log)
 - (8) how well bottom plugged Pin


description of formations encountered	from	to
Clay	0	23
Sand	23	108
Blue-Gray Clay	108	220
Shale	220	344
Five Sand	344	350
Shale	350	520
Good Sand	520	560

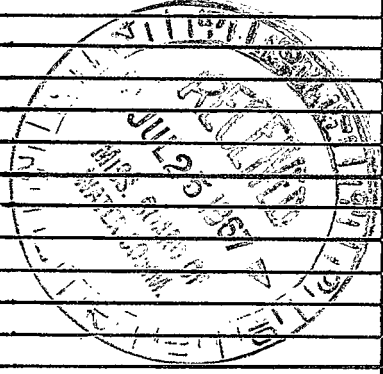

DRILLERS REMARKS:

If well telescopes please sketch and show depths.

GROUND LEVEL

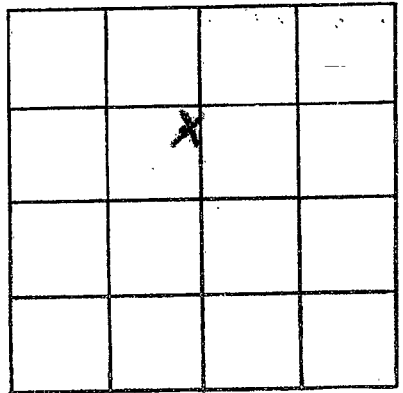

SECTION 20

Please indicate well location X.

ADDITIONAL INFORMATION

If more than one screen, show locations of each on sketch.