

F26

10-14-63

WATER WELL DRILLERS LOG

CODED

Date: 10/14, 1963, Driller: Bailey Drilg Co County Washington
 (Name)

- (1) Owner of Land: D O Baker
 (Name)
Leland, Miss.
 (Address)
- (2) Location: SW 1/4, NW 1/4, Sec. 16 Dunloith
18 R 6
4 miles E of Leland
 (distance) (direction) (Nearest Town)
- (3) Topography: Flat
 (Hilly) (Flat) (Level)
- (4) Purpose of Well: Domestic
 (Domestic Irrigation
 Municipal, Industrial, Other)


Description & Color of Materials Sand, Clay, Red Clay, Shell, etc.	Thick- ness Feet	Depth Feet
<u>Clay</u>		<u>16</u>
<u>Grill</u>		<u>90</u>
<u>Gravel</u>		<u>126</u>
<u>Mud</u>		<u>339</u>
<u>Rock</u>		<u>340</u>
<u>Grill + Mud</u>		<u>392</u>
<u>Mud</u>		<u>508</u>
<u>Sand</u>		<u>544</u>

Information upon completion of well:

- (1) Diameter 4 x 2 1/2 inches.
- (2) Total Depth 544 feet.
- (3) Water Level 21 1/2 feet below top of ground.
- (4) Cased to all way Size 4 x 2 1/2
- (5) Screen: Size 2 1/2, Length 30 ft
- (6) Were any formations sealed against pollution?
 _____ yes, X no.

CODED

If YES depth of formation _____
 Why _____
 Drillers Remarks: _____

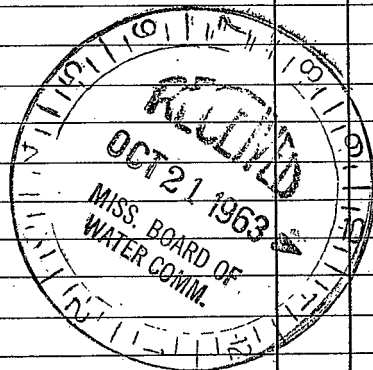

(Use Back Side)

Well No.

