

F27

5-66

WATER WELL DRILLERS LOG

Washington

Date: May 7, 1966, Driller: Butane Gas Co. of Greenwood County Florida  
 (Name)

(1) Owner of Land: Dan Smythe  
 (Name)  
Leland, Miss.  
 (Address)

(2) Location: SE 1/4, NE 1/4, Sec. 35 18 6  
T. N. RW.  
5 miles So. East, of Leland  
 (distance) (direction) (Nearest Town)

(3) Topography: Flat  
 (Hilly) (Flat) (Level)

(4) Purpose of Well: Irrigation  
 (Domestic Irrigation  
 Municipal, Industrial, Other)

Description & Color of Materials Sand, Clay, Red Clay, Shell, etc.	Thick- ness Feet	Depth Feet
Clay	13	13
"	10	23
Fine Sand	10	33
Sand & small gravel	10	43
Fine Sand	10	53
Med. Sand	10	63
Sand & gravel	10	73
Coarse Sand	10	83
Sand & Gravel	10	93

Information upon completion of well:

(1) Diameter 16 inches.

(2) Total Depth 93 feet.

(3) Water Level 19 feet below top of ground.

(4) Cased to 53, Size 16


(5) Screen: Size 16, Length 40

(6) Were any formations sealed against pollution?  
no,  yes,  no.

If YES depth of formation \_\_\_\_\_

Why \_\_\_\_\_

Drillers Remarks: \_\_\_\_\_

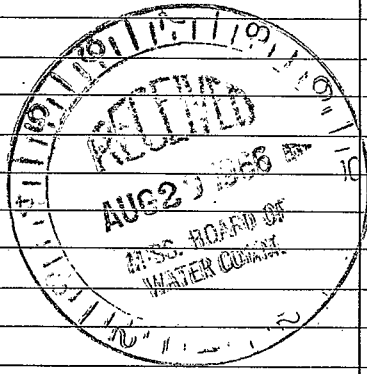

Elev 3.112'

(Use Back Side)

Well No.

