

Washington  
 F 28  
 1-67

MISSISSIPPI  
 BOARD OF WATER COMMISSIONERS  
 416 North State Street  
 Jackson, Mississippi 39201

WATER WELL DRILLERS LOG

1/25-1967 Bailey Drlg Co Washington  
 date well completed firm name county well located

LANDOWNER: Henry Sprole  
 Leland  
 Miss.  
 (mailing address)

description of formations encountered	from	to
Clay	0	20
Sand	20	75
Gravel	75	118
Mud	118	200
Fine sand & Mud	200	320
Mud	320	500
Sand & mud	500	578
Mud	578	600
Sand	600	674

WELL LOCATION:  
 sec. 20 T. 18 N. R. 6 E.  
 4 miles SE of Leland.  
 (distance) (direction) (nearest town)

WELL PURPOSE: Home  
 (home, irrigation, municipal, industrial)


- WELL COMPLETION DATA:
- (1) diameter (inches) 4 x 2
  - (2) total depth (feet) 674
  - (3) static water level (feet) 25 below top of ground
  - (4) casing Galv, 660, (material), (depth)  
 4 x 2 (size) if telescope see back.
  - (5) screen 14, 660 (length), (depth to top)  
 2" (size), stainless steel (material)
  - (6) pump 1/2 (HP), 10 (yield gpm)  
 Electric (type power)
  - (7) electric log no (yes or no)

(organization running log)  
 (8) how well bottom plugged Back pressure valve

DRILLERS REMARKS:



If well telescopes please sketch and show depths.

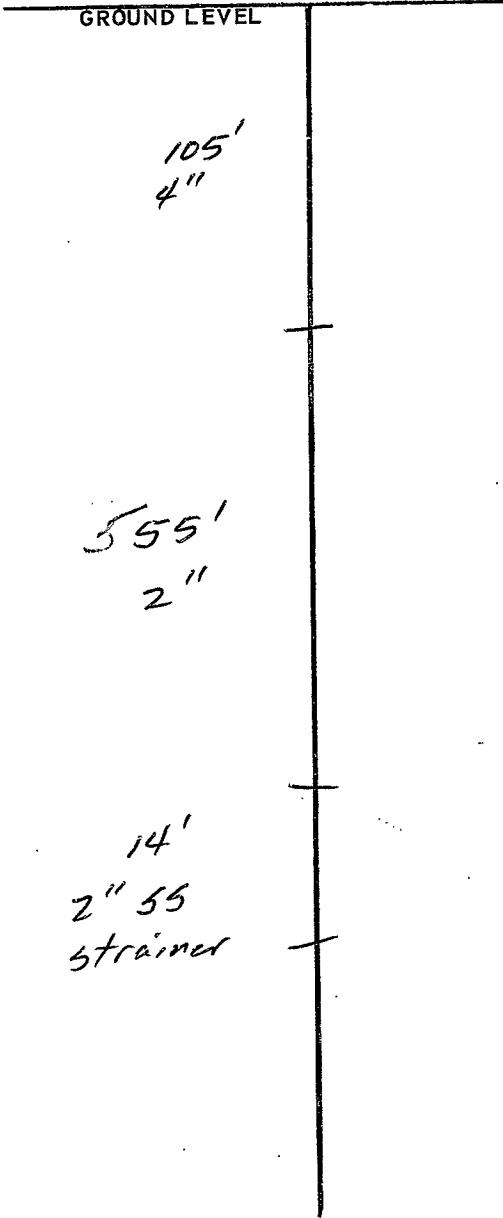

X			

SECTION 20

Please indicate well location X.

ADDITIONAL INFORMATION

Series of horizontal lines for recording additional information.

If more than one screen, show locations of each on sketch.