

Washington
F 30
3-68

MISSISSIPPI
BOARD OF WATER COMMISSIONERS
416 North State Street
Jackson, Mississippi 39201

CODED

WATER WELL DRILLERS LOG

14 May 68 19 Little Pump & Concrete Well Serv. Wash.
date well completed firm name county well located

LANDOWNER: James O. Wray
Leland, Miss.

description of formations encountered from to

(mailing address)

WELL LOCATION:
sec. 20 T. 18 (N) R. 6 E
2 1/2 miles E of Leland
(distance) (direction) (nearest town)

Clay		
Clay	0	15
Sand	15	65
Deep Gravel	65	115
Blue Clay	115	150
Strips. Sand & Clay	150	180
Blue Shell	180	225
Rock	225	230
Blue Clay	230	255
Sand	255	270
Blue Clay	270	345
Sand	345	360
Blue Clay	360	380
Sand	380	390
Blue Clay	390	440
Sand	440	455
Rock	455	460
Clay	460	465
good Sand	465	478
Clay	478	520

WELL PURPOSE:
(home, irrigation, municipal, industrial)

WELL COMPLETION DATA:

- (1) diameter (inches) 2"
- (2) total depth (feet) 520
- (3) static water level (feet) 42 below top of ground.
- (4) casing galv., 478,
(material) (depth)
10' If telescope see back.
(size)
- (5) screen 10', 478
(length) (depth to top)
2", S. Steel
(size) (material)
- (6) pump 1 150 hr.
(HP) (yield gpm)
Elect.
(type power)
- (7) electric log no.
(yes or no)


(organization running log)

(8) how well bottom plugged steel
tapered plug

DRILLERS REMARKS:

If well telescopes please sketch and show depths.

GROUND LEVEL

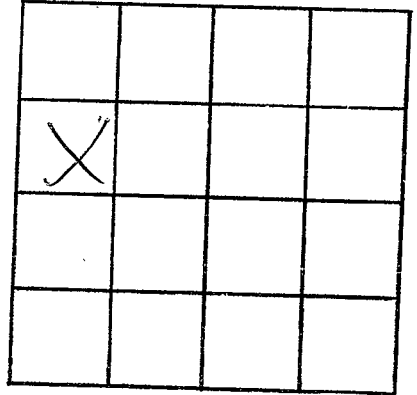

SECTION 20

Please indicate well location X.

ADDITIONAL INFORMATION



If more than one screen, show locations of each on sketch.