

F 31
8-13-63

WATER WELL DRILLERS LOG

Date: 8/13/63, 19___, Driller: Bailey Drilling Co. Washington County (Name)

(1) Owner of Land: Robert Maugh (Name)
Leland, Miss. (Address)

(2) Location: 33 18 N 0 W
1/4, 1/4, Sec. T R
6 miles SE of Leland
(distance) (direction) (Nearest Town)

(3) Topography: Flat
(Hilly) (Flat) (Level)

(4) Purpose of Well: Domestic
(Domestic Irrigation
Municipal, Industrial, Other)

Description & Color of Materials Sand, Clay, Red Clay, Shell, etc.	Thick- ness Feet	Depth Feet
Clay		23
Sand		70
Gravel		95
Mud		280
Sand		314

CODED

Information upon completion of well:

(1) Diameter 4x2 inches.


(2) Total Depth 314 feet.

(3) Water Level 15 feet below top of ground.

(4) Cased to all way Size 4x2

(5) Screen: Size 2 Length 20ft.

(6) Were any formations sealed against pollution?
yes, X no.

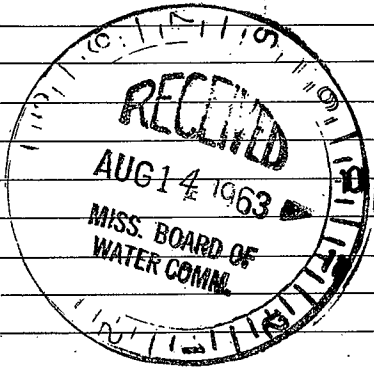

Insuff info to locate

If YES depth of formation _____

Why _____

Drillers Remarks: _____

Elev 112' ±

(Use Back Side)

Well No.

