

CODED

Washington
736
6-25-69

MISSISSIPPI
BOARD OF WATER COMMISSIONERS
416 North State Street
Jackson, Mississippi 39201

WATER WELL DRILLERS LOG

June 25 1969 Schultz Schultz Washington
date well completed firm name county well located

LANDOWNER: Jimmy Lee
Donnell Plonier
Leland Miss
(mailing address)

description of formations encountered	from	to
	Clay	0
Sand	16	99

WELL LOCATION:
sec. 4 T. 18 N R. 6 E
5 miles N-NE of Leland
(distance) (direction) (nearest town)

WELL PURPOSE: Home
(home, irrigation, municipal, industrial)

- WELL COMPLETION DATA:
- (1) diameter (inches) 2"
 - (2) total depth (feet) 94
 - (3) static water level (feet) 20 below top of ground.
 - (4) casing 2" (material), (depth)
 - (5) screen 10" (length), (depth to top)
2" (size), (material)
 - (6) pump (HP), (yield gpm)
(type power)
 - (7) electric log NO (yes or no)
(organization running log)
 - (8) how well bottom plugged


DRILLERS REMARKS:

JUL 11 1969

MISSISSIPPI
BOARD OF WATER COMMISSIONERS

If well telescopes please sketch and show depths.

GROUND LEVEL

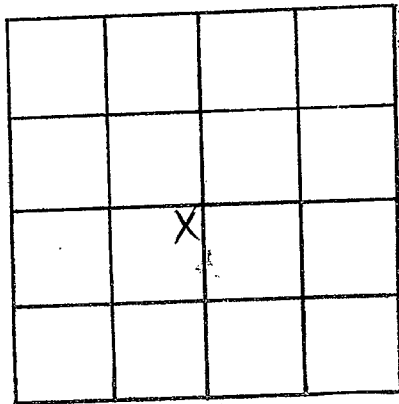

SECTION 4

Please indicate well location X.

ADDITIONAL INFORMATION

If more than one screen, show locations of each on sketch.