

WASHINGTON

F 37

8-14-70

MISSISSIPPI
 BOARD OF WATER COMMISSIONERS
 416 North State Street
 Jackson, Mississippi 39201

CODED

WATER WELL DRILLERS LOG

8/14 1970
date well completed

Boiles Drilling Co.
firm name

Washington
county well located

LANDOWNER: Fratelli Bros.

description of formations encountered

from to

Leland

Miss.

(mailing address)

WELL LOCATION:

sec 21 T 18 N R 6 E
 4 miles SE of Leland
 (distance) (direction) (nearest town)

| | | |
|------------|-----|-----|
| Clay | 0 | 10 |
| Sand | 10 | 69 |
| Gravel | 69 | 120 |
| Mud | 120 | 210 |
| Sand & Mud | 210 | 220 |
| Mud | 220 | 266 |
| Sand | 266 | 286 |
| Mud | 286 | 297 |
| Sand | 297 | 345 |

WELL PURPOSE: Home
(home, irrigation, municipal, industrial)

WELL COMPLETION DATA:

- (1) diameter (inches) 4 X 2
- (2) total depth (feet) 345
- (3) static water level (feet) 20 below above top of ground.
- (4) casing Steel, 325
(material) (depth)
4 X 2 if telescope see back.
(size)
- (5) screen 20', 325
(length) (depth to top)
2", Stainless Steel
(size) (material)
- (6) pump 1/2, 25
(HP) (yield gpm)
Elec
(type power)
- (7) electric log No.
(yes or no)

CODED

AUG 18 1970

(organization running log)

(8) how well bottom plugged
back pressure valve

MISS. BD. OF
WATER COM.

DRILLERS REMARKS:


If well telescopes please sketch and show depths.

GROUND LEVEL

147' 9"

175' 0"

of 2 screens

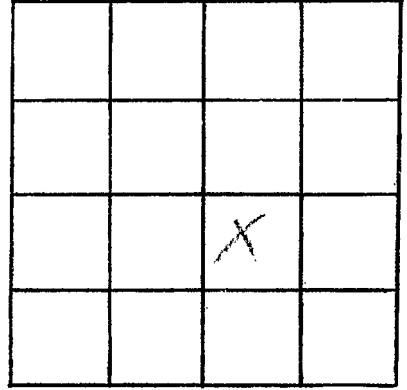

SECTION _____

Please indicate well location X.

ADDITIONAL INFORMATION

If more than one screen, show locations of each on sketch.