

WASHINGTON  
F38  
3-15-71

MISSISSIPPI  
BOARD OF WATER COMMISSIONERS  
416 North State Street  
Jackson, Mississippi 39201

**CODED**

WATER WELL DRILLERS LOG

3-15 1971 Schutte Drilling Washington  
date well completed firm name county well located

LANDOWNER: <u>Howard Fleming</u>	description of formations encountered	from	to
<u>Leland Miss</u> (mailing address)	<u>clay</u> <u>sand</u>	<u>0</u> <u>18</u>	<u>18</u> <u>80</u>
<b>WELL LOCATION:</b> sec <u>3</u> T <u>18</u> N R <u>6</u> E <u>5</u> miles <u>E-NE</u> of <u>Leland</u> (distance) (direction) (nearest town)			
<b>WELL PURPOSE:</b> <u>farm</u> (home, irrigation, municipal, industrial)			
<b>WELL COMPLETION DATA:</b>			
(1) diameter (inches) <u>2"</u>			
(2) total depth (feet) <u>69</u>			
(3) static water level (feet) <u>17</u> below top of ground.			
(4) casing <u>galv</u> (material) (depth) (size) if telescope see back.			
(5) screen <u>4ft</u> (length) (depth to top) <u>2"</u> <u>Plastic</u> (size) (material)			
(6) pump <u>1</u> <u>15</u> (HP) (yield gpm) <u>elec</u> (type power)			
(7) electric log <u>no</u> (yes or no) <u>✓</u> (organization running log)			
(8) how well bottom plugged <u>plug</u>			
DRILLERS REMARKS:			


**CODED**

MAR 30 1971

MISS. BD. OF  
WATER COMMISSIONERS

If well telescopes please sketch and show depths.

GROUND LEVEL

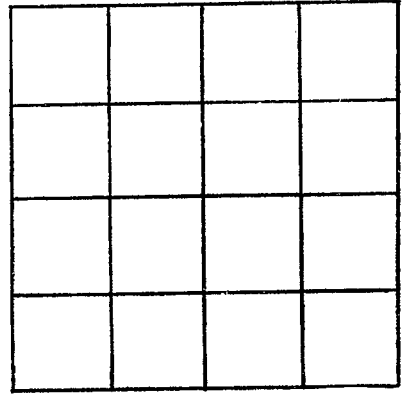

SECTION \_\_\_\_\_

Please indicate well location X.

ADDITIONAL INFORMATION

If more than one screen, show locations of each on sketch.