

MISSISSIPPI  
BOARD OF WATER COMMISSIONERS  
416 North State Street  
Jackson, Mississippi 39201

WATER WELL DRILLERS LOG

**CODED**

WASHINGTON  
F 39  
6-8-71

6-8-71 date well completed 1971 Sebulla Drilling firm name Washington county well located

LANDOWNER: <u>Morgan Fleming</u>	description of formations encountered	from	to
<u>Leland, Miss</u> (mailing address)	<u>Clay</u>	<u>0</u>	<u>16</u>
	<u>Sand</u>	<u>16</u>	<u>100</u>

WELL LOCATION:  
sec. 10 T. 18 N R. 6 E  
7 miles East of Leland  
(distance) (direction) (nearest town)

WELL PURPOSE: Individual  
(home, irrigation, municipal, industrial)

- WELL COMPLETION DATA:
- (1) diameter (inches) 4"
  - (2) total depth (feet) 100
  - (3) static water level (feet) 16 below top of ground.
  - (4) casing Plastic  
(material) (depth)
  - (size) if telescope see back.
  - (5) screen 20ft  
(length) (depth to top)
  - 4" Plastic  
(size) (material)
  - (6) pump 2 106  
(HP) (yield gpm)
  - 3/4 sec  
(type power)
  - (7) electric log No  
(yes or no)
  - (organization running log)
  - (8) how well bottom plugged Plug

**CODED**


JUL 9 1971

MISS. BD. OF  
WATER COM.

DRILLERS REMARKS:

If well telescopes please sketch and show depths.

GROUND LEVEL

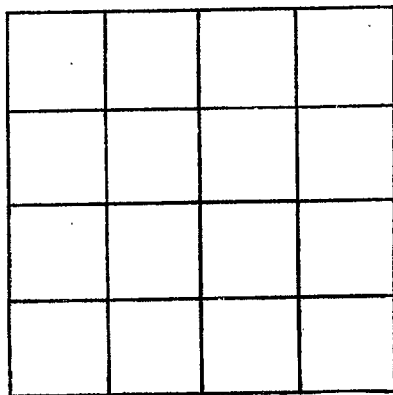

SECTION \_\_\_\_\_

Please indicate well location X.

ADDITIONAL INFORMATION

If more than one screen, show locations of each on sketch.