

09-10-71

WASHINGTON
F41
9-10-71

MISSISSIPPI
BOARD OF WATER COMMISSIONERS
416 North State Street
Jackson, Mississippi 39201

CODED

WATER WELL DRILLERS LOG

9-10 date well completed 1971 Schultz Drilling firm name Washington county well located

LANDOWNER: <u>Boque Baglister</u>	Description of formations encountered	from	to
<u>Leland, Miss</u> (mailing address)	<u>Clay</u>	<u>0</u>	<u>18</u>
WELL LOCATION: sec <u>6</u> T <u>18</u> N R <u>6</u> E <u>2</u> miles N of <u>Leland</u> (distance) (direction) (nearest town)	<u>Sand</u>	<u>18</u>	<u>137</u>
WELL PURPOSE: <u>Church</u> (home, irrigation, municipal, industrial)	<u>Clay</u>	<u>137</u>	<u>281</u>
WELL COMPLETION DATA: (1) diameter (inches) <u>2"</u>	<u>Sand</u>	<u>281</u>	<u>341</u>
(2) total depth (feet) <u>578</u>	<u>Shale</u>	<u>341</u>	<u>382</u>
(3) static water level (feet) <u>28</u> (below/above top of ground)	<u>Sand</u>	<u>382</u>	<u>402</u>
(4) casing <u>Galv</u> <u>508</u> (material) (depth)	<u>Clay</u>	<u>402</u>	<u>438</u>
(size) if telescope see back.	<u>Sand</u>	<u>438</u>	<u>524</u>
(5) screen <u>10</u> <u>508</u> (length) (depth to top)			
<u>2"</u> <u>STAINLESS</u> (size) (material)			
(6) pump <u>1</u> <u>12</u> (HP) (yield gpm)			
<u>ELC</u> (type power)			
(7) electric log <u>NO</u> (yes or no)			
(organization running log)			
(8) how well bottom plugged <u>Shale</u>			
DRILLERS REMARKS:			


CODED

OCT 8 1971

MISS. BD. OF
WATER COM.

If well telescopes please sketch and show depths.

GROUND LEVEL

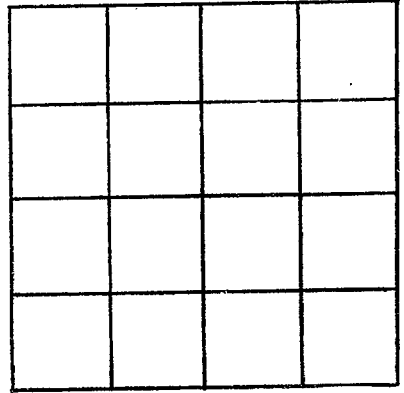

SECTION _____

Please indicate well location X.

ADDITIONAL INFORMATION

If more than one screen, show locations of each on sketch.