

WASHINGTON  
F45

10-9-72  
Elev #

10/9  
date well completed

MISSISSIPPI  
BOARD OF WATER COMMISSIONERS  
416 North State Street  
Jackson, Mississippi 39201

WATER WELL DRILLERS LOG

1972 Schultz Drilling Co  
firm name

Washington  
county well located

| LANDOWNER:   | description of formations encountered | from | to         |
|--|---------------------------------------|------|------------|
| 238 Taylor<br>GREENVILLE Miss<br>(mailing address)   | Co/ry<br>Sand                         | 0    | 16<br>126  |
| WELL LOCATION:<br>sec 35 T 18 N R 6 E<br>1 miles East of Tribbett<br>(distance) (direction) (nearest town) | Sandy Shale<br>Hard Shale             | 126  | 163<br>247 |
| WELL PURPOSE: <u>Drinking water</u><br>(home, irrigation, municipal, industrial)                           | Sand                                  | 247  | 355        |
| WELL COMPLETION DATA:  | Shale + Sand Shale                    | 355  | 535        |
| (1) diameter (inches) <u>4 x 2</u>   | Sand                                  | 535  | 631        |
| (2) total depth (feet) <u>635</u>  |                                       |      |            |
| (3) static water level (feet) <u>22</u> below top of ground.   |                                       |      |            |
| (4) casing <u>PVC</u> (material) (depth)   |                                       |      |            |
| (size) If telescope see back.  |                                       |      |            |
| (5) screen <u>30</u> (length) (depth to top)   |                                       |      |            |
| <u>2"</u> (size) <u>PVC</u> (material)   |                                       |      |            |
| (6) pump <u>2</u> (HP) <u>35</u> (yield gpm)   |                                       |      |            |
| <u>Elc</u> (type power)  |                                       |      |            |
| (7) electric log <u>yes</u> (yes/or no)  |                                       |      |            |
| (organization running log)   |                                       |      |            |
| (8) how well bottom plugged <u>5/ wash</u>   |                                       |      |            |
| DRILLERS REMARKS:<br><u>This Well Was to Fill<br/>Chemical Tanks</u>                                       |                                       |      |            |



COPIED

FEB 5 1973

MISS. BO. OF  
WATER COMMISSIONERS

If well telescopes please sketch and show depths.

GROUND LEVEL

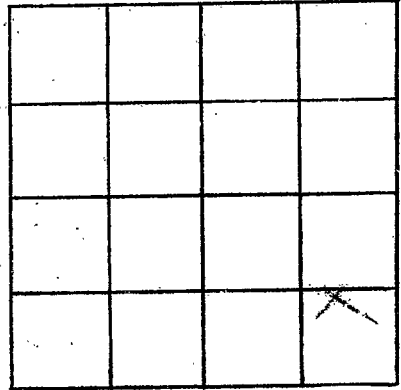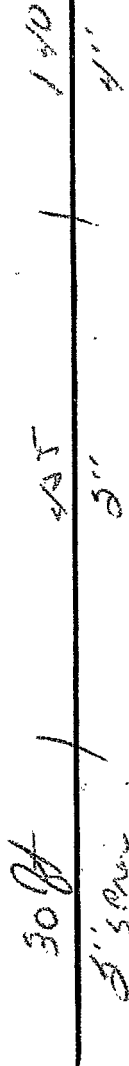

SECTION 35

Please indicate well location X.

ADDITIONAL INFORMATION

If more than one screen, show locations of each on sketch.