

F 47
 WASHINGTON
 3-30-73

MISSISSIPPI
 BOARD OF WATER COMMISSIONERS
 416 North State Street
 Jackson, Mississippi 39201

CODED

WATER WELL DRILLERS LOG

3/30 1973 Schutte Drilling Co Washington
 date well completed firm name county well located


LANDOWNER: Jimmy Reed	description of formations encountered	from	to
Salond Miss (mailing address)	clay	0	14
	sand	14	143
WELL LOCATION: sec. 4 T. 18 N. R. 6 E. W. 5 miles N.E. of Salond (distance) (direction) (nearest town)	clay & shell	143	290
	sand	290	390
WELL PURPOSE: (home, irrigation, municipal, industrial)	shell	390	401
WELL COMPLETION DATA:	sand	401	489
(1) diameter (inches) 4 x 2 1/2			
(2) total depth (feet) 489			
(3) static water level (feet) 29 below top of ground.			
(4) casing steel (material) (depth) (size) if telescope see back.			
(5) screen 30 (length) (depth to top) 2 1/2 Stainless (size) (material)			
(6) pump 3 (HP) 20 (yield gpm) other (type power)			
(7) electric log 20 (yes or no) (organization running log)			
(8) how well bottom plugged Spunk			

CODED

DRILLERS REMARKS: AUG 22 1973

If well telescopes please sketch and show depths.

GROUND LEVEL

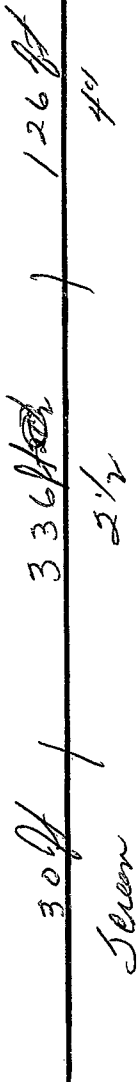

*			

SECTION 4

Please indicate well location X.

ADDITIONAL INFORMATION

If more than one screen, show locations of each on sketch.