

WASH
F48
1-20-74

MISSISSIPPI
BOARD OF WATER COMMISSIONERS
416 North State Street
Jackson, Mississippi 39201

CODED

WATER WELL DRILLERS LOG

20 Jan 1974 Lambert Drilling Co Wash
date well completed firm name county well located

LANDOWNER:
Cous Piovallsi Jr.
Leland, Miss.
(mailing address)

WELL LOCATION:
sec. 3 T. 18 N R. 6 E W
7 miles E. of Leland
(distance) (direction) (nearest town)

WELL PURPOSE: home
(home, irrigation, municipal, industrial)


WELL COMPLETION DATA:
(1) diameter (inches) 4x2
(2) total depth (feet) 492
(3) static water level (feet) 36 below above top of ground.
(4) casing Steel, 472, (material) (depth)
4x2 (size) if telescope see back.
(5) screen 20' 492-472 (length) (depth to top)
2" S.S. (size) (material)
(6) pump 1 19 (HP) (yield gpm)
Elect (type power)
(7) electric log (yes or no)
(organization running log)
(8) how well bottom plugged Back wash

description of formations encountered	from	to
Mixed	0	30
Sand	30	80
Sand & gravel	80	165
Sand	165	240
Clay	240	290
Sand st. clay	290	330
Sand med.	330	360
Sand good	360	500

RECEIVED
MAR 29 1974

DRILLERS REMARKS:

If well telescopes please
sketch and show depths.

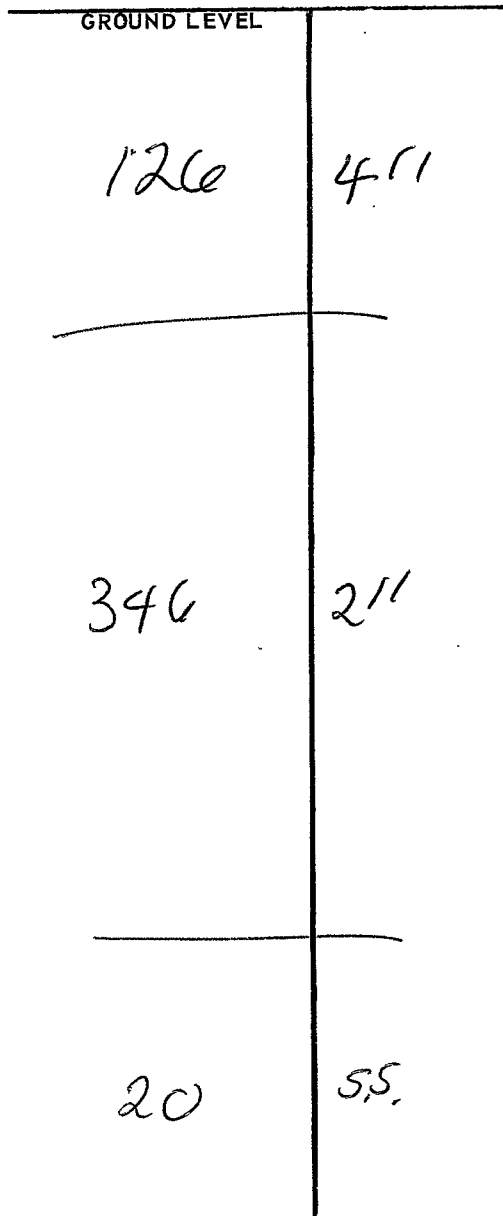

		X	

SECTION 3

Please indicate well location X.

ADDITIONAL INFORMATION

Additional information section consisting of multiple horizontal lines for notes.

If more than one screen,
show locations of each on sketch.