

WASH.
F 49
5/79

MISSISSIPPI
BOARD OF WATER COMMISSIONERS
416 North State Street
Jackson, Mississippi 39201

CODED

WATER WELL DRILLERS LOG

date well completed 19 74 firm name Owens plb. county well located Wash.

LANDOWNER: Perry Patterson

description of formations encountered	from	to
top soil	0	20
Sand	20	126
clay	126	147
Sand & gravel	147	167
Sand	167	460

(mailing address)

WELL LOCATION:
sec 20 T 18 N R 6 E
3 miles E of Leland
(distance) (direction) (nearest town)

WELL PURPOSE: Stand
(home, irrigation, municipal, industrial)

WELL COMPLETION DATA:

- (1) diameter (inches) 2"
- (2) total depth (feet) 460'
- (3) static water level (feet) 16' below top of ground.
- (4) casing Galv. 450'
(material) (depth)
- (size) If telescope see back.
- (5) screen 10' 460'
(length) (depth to top)
- 2" S.S.
(size) (material)
- (6) pump 1 1
(HP) (yield gpm)
- Elec.
(type power)
- (7) electric log No.
(yes or no)
- (organization running log)
- (8) how well bottom plugged S.B.


CODED

MISSISSIPPI
BOARD OF WATER COMMISSIONERS
JAN 9 1979
MISSISSIPPI

DRILLERS REMARKS: Owens

If well telescopes please sketch and show depths.

GROUND LEVEL

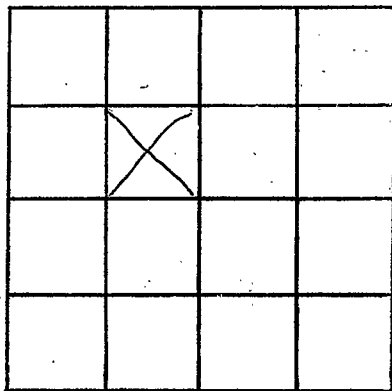

SECTION _____

Please indicate well location X.

ADDITIONAL INFORMATION

If more than one screen, show locations of each on sketch.