

WASH.  
F51  
5-19-79

MISSISSIPPI  
BOARD OF WATER COMMISSIONERS  
416 North State Street  
Jackson, Mississippi 39201

CODED

WATER WELL DRILLERS LOG

5-19 1979 Schultz Drilling Washington  
date well completed firm name county well located

LANDOWNER: Frank Turner  
  
Leland Miss  
(mailing address)  
  
WELL LOCATION:  
sec 34 T 18 N R 6 W  
5 miles S.E. of Leland  
(distance) (direction) (nearest town)  
  
WELL PURPOSE: Home  
(home, irrigation, municipal, industrial)

description of formations encountered	depth	
	from	to
Top Soil	0	19
Sand	19	112
Shale + Clay	112	336
Sand	336	380
Clay	380	410
<del>Sand</del>	410	460


WELL COMPLETION DATA:  
 (1) diameter (inches) 2"  
 (2) total depth (feet) 440  
 (3) static water level (feet) 24 below top of ground.  
 (4) casing P.V.C. (material), (depth),  
 (size) if telescope see back.  
 (5) screen 10 (length), (depth to top)  
 2" (size), P.V.C. (material)  
 (6) pump 1 (HP), 10 (yield gpm)  
 Elec (type power)  
 (7) electric log No (yes or no)  
 (organization running log)  
 (8) how well bottom plugged S/WAS

DRILLERS REMARKS:

DEC 13 1974  
 MISS. BB. OF WATER COMMISSIONERS

If well telescopes please sketch and show depths.

GROUND LEVEL

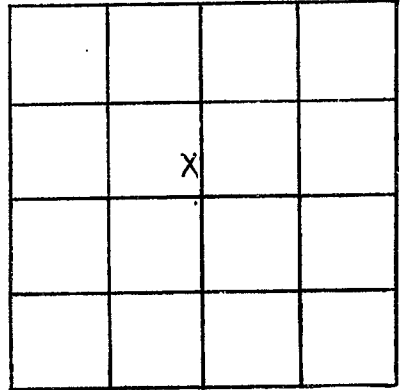

SECTION 32

Please indicate well location X.

ADDITIONAL INFORMATION

If more than one screen,  
show locations of each on sketch.