

WASHINGTON

F 52

08-10-77

MISSISSIPPI BOARD OF WATER COMMISSIONERS  
416 North State Street  
Jackson, Mississippi 39201

CODED

WATER WELL DRILLERS LOG

10 aug date well completed

1977 Lambert Drilling firm name

Wash county well located

LANDOWNER: Harry Frates

Leland, Miss.

(mailing address)

WELL LOCATION:

sec 18 T 18 N R 6 E  
3 miles E of Leland  
(distance) (direction) (nearest town)

WELL PURPOSE: home  
(home, irrigation, municipal, industrial)

WELL COMPLETION DATA:

- (1) diameter (inches) 6x3
- (2) total depth (feet) 540
- (3) static water level (feet) 30 below top of ground.
- (4) casing Steel 510 (material) (depth) 4x3 if telescope see back. (size)
- (5) screen 30 540-510 (length) (depth to top) 3 S.S. (size) (material)
- (6) pump 10 100 (HP) (yield gpm) elect (type power)
- (7) electric log (yes or no)

(organization running log)

(8) how well bottom plugged back wash

DRILLERS REMARKS:

description of formations encountered

from to

Mixed 0 20

Sand 20 60

Sand & CODED 60 110

clay 110 150

Clay & Sand 150 269

Rock 269 270

Sand 270 302

Rock 302 303

Sand 303 490

Sand 490 540

RECEIVED  
DEC 8 1977

MISS. BD. OF WATER COMMISSIONERS

If well telescopes please sketch and show depths.

GROUND LEVEL


148 6"



342 3"



30 3"

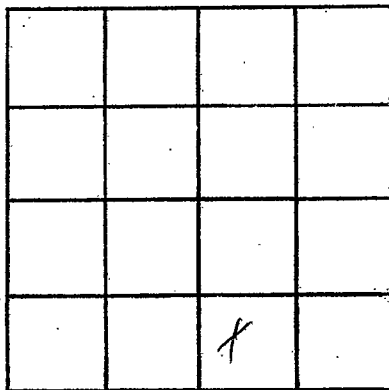

SECTION 18

Please indicate well location X.

ADDITIONAL INFORMATION

If more than one screen, show locations of each on sketch.