

WASHINGTON
F 58

MISSISSIPPI
BOARD OF WATER COMMISSIONERS
416 North State Street
Jackson, Mississippi 39201

CODED

17-72-80

WATER WELL DRILLERS LOG

Dec. 22 1980
date well completed

Thomas P. Sen Washington
firm name county well located

LANDOWNER: Tiddie Davidson
Greenwood, Ms.
(mailing address)

WELL LOCATION:
sec. 20 T. 18 N R. 6 E
S W
E miles 8 of Beardville
(distance) (direction) (nearest town)
GREENVILLE

WELL PURPOSE:
(home, irrigation, municipal, industrial)

WELL COMPLETION DATA:

- (1) diameter (inches) 4 X 2
- (2) total depth (feet) 540
- (3) static water level (feet) 25 ^(below) above top of ground.
- (4) casing PVC 442
(material) (depth)
4 X 2 If telescope see back.
(size)
- (5) screen 30 442
(length) (depth to top)
2 100 lot PVC
(size) (material)
- (6) pump 1 25
(HP) (yield gpm)
260
(type power)
- (7) electric log No
(yes or no)
- (organization running log)
- (8) how well bottom plugged Point

DRILLERS REMARKS:

description of formations encountered	from	to
Dirt	0	15
Brown SAND	15	70
Coarse SAND w/STKS	70	120
SMALL GRAVEL		
Grey-Brown & Blue mud SAND	120	442
SAND	442	475
mostly CHALK w/STKS SAND	475	535
SAND		
CHALK	535	538
	538	540

DEPT. OF NATURAL RESOURCES
BUREAU OF LAND & WATER RESOURCES

JAN 19 1981

RECEIVED

If well telescopes please sketch and show depths.

3116

GROUND LEVEL

4" PVC
TO


90 FT

2" PVC
TO

42 FT

2" 105/8" PVC Screen
TO 472

2" PVC
TO
540

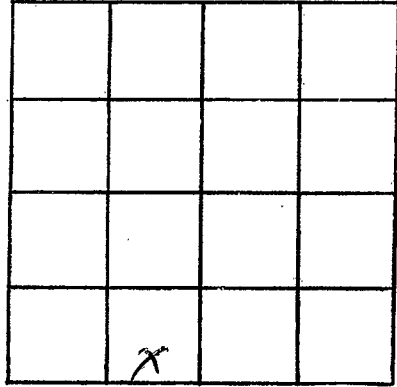

SECTION 20

Please indicate well location X.

ADDITIONAL INFORMATION

Multiple horizontal lines for additional information.

If more than one screen, show locations of each on sketch.