

MISSISSIPPI DEPARTMENT OF NATURAL RESOURCES

Bureau of Land and Water Resources

Southport Mall

P.O. Box 10631

Jackson, Mississippi 39209

WATER WELL DRILLERS LOG

Wash  
F60  
6-26-81

6-26 19 81 Butane Co Washington  
date well completed firm name county well located  
Greenwood Ms

LANDOWNER:  
Bo Neill  
Indianola, Ms  
(mailing address)

description of formations encountered	CODED	
	from	to
CLAY	0	12
fine sand	12	25
SAND	25	69
SAND + gravel	69	113
CLAY	113	114

WELL LOCATION:  
sec. 25 T. 18 N R. 6 E  
6 miles S-W of Indianola  
(distance) (direction) (nearest town)

WELL PURPOSE: Irrigation  
(home, irrigation, municipal, industrial)

WELL COMPLETION DATA:

(1) diameter (inches) 16"

(2) total depth (feet) 114

(3) static water level (feet) 25 below above top of ground. CODED

(4) casing steel, 94 (material) (depth)  
16 (size) if telescope see back.

(5) screen 40' (length) 74 (depth to top)  
16" (size) steel (material)

(6) pump 150 (HP) 1800 (yield gpm)  
Diesel (type power)

(7) electric log (yes or no)  
(organization running log)

(8) how well bottom plugged  
Steel plate


DRILLERS REMARKS:

DEPT. OF NATURAL RESOURCES  
BUREAU OF LAND & WATER RESOURCES  
JUL - 2 1981

RECEIVED

If well telescopes please sketch and show depths.

GROUND LEVEL

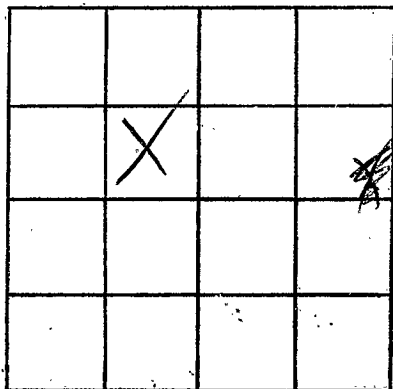

SECTION 20

Please indicate well location X.

ADDITIONAL INFORMATION

If more than one screen,  
show locations of each on sketch.