

MISSISSIPPI DEPARTMENT OF NATURAL RESOURCES

Bureau of Land and Water Resources

Southport Mall

P.O. Box 10631

Jackson, Mississippi 39209

WATER WELL DRILLERS LOG

CODED

Washington
F 61
5-11-81

May 11 1981 date well completed Larry's well & pump firm name Washington county well located

LANDOWNER: <u>George Rize</u>	description of formations encountered	from	to
<u>Andalusia, Miss</u> (mailing address)			
	<u>Clay</u>	<u>0</u>	<u>33</u>
	<u>fine sand</u>	<u>33</u>	<u>50</u>
	<u>Coarse Sand</u>	<u>50</u>	<u>100</u>

WELL LOCATION:
 sec. 17 T 18 N R. 6
5 miles E of Island
 (distance) (direction) (nearest town)

WELL PURPOSE:
 (home, irrigation, municipal, industrial)

- WELL COMPLETION DATA:
- (1) diameter (inches) 8"
 - (2) total depth (feet) 100'
 - (3) static water level (feet) 22 below top of ground.
 - (4) casing Plastic, 60',
 (material) (depth)
 (size) if telescope see back.
 - (5) screen 40', 60'
 (length) (depth to top)
8", Plastic
 (size) (material)
 - (6) pump 10 700
 (HP) (yield gpm)
 (type power)
 - (7) electric log NO
 (yes or no)
 (organization running log)
 - (8) how well bottom plugged PVC
cap

CODED

DEPT. OF NATURAL RESOURCES
 BUREAU OF LAND & WATER RESOURCES


OCT 15 1981

RECEIVED

DRILLERS REMARKS:

If well telescopes please
.. sketch and show depths.

GROUND LEVEL

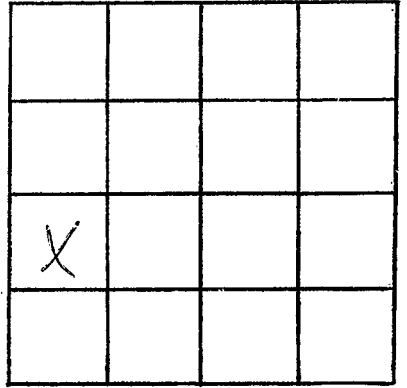

SECTION 17

Please indicate well location X.

ADDITIONAL INFORMATION

If more than one screen,
show locations of each on sketch.