

MISSISSIPPI DEPARTMENT OF NATURAL RESOURCES

Bureau of Land and Water Resources

Southport Mall

P.O. Box 10631

Jackson, Mississippi 39209

WATER WELL DRILLERS LOG

CODED

Washington
F 62
5-11-81

May 11 1981 date well completed
Larrin's well & pump firm name
Washington county well located

LANDOWNER: George Rice
Indianola, Ms.
(mailing address)

description of formations encountered	from	to
Clay	0	25
Fine Sand	25	50
Course Sand	50	100

WELL LOCATION:
sec. 17-18 N R-6
5 miles E of Lebanon
(distance) (direction) (nearest town)

WELL PURPOSE:
(home, irrigation, municipal, industrial)

WELL COMPLETION DATA:

(1) diameter (inches) 8"

(2) total depth (feet) 100'

(3) static water level (feet) 20 below above top of ground.

(4) casing Plastic, 60'
(material) (depth)
(size) if telescope see back.

(5) screen 40', 60'
(length) (depth to top)
8", Plastic
(size) (material)

(6) pump 10, 700
(HP) (yield gpm)
(type power)

(7) electric log No.
(yes or no)
(organization running log)

(8) how well bottom plugged Pvc
cap

DRILLERS REMARKS:

CODED


DEPT. OF NATURAL RESOURCES
BUREAU OF LAND & WATER RESOURCES

OCT 15 1981

RECEIVED

If well telescopes please sketch and show depths.

GROUND LEVEL

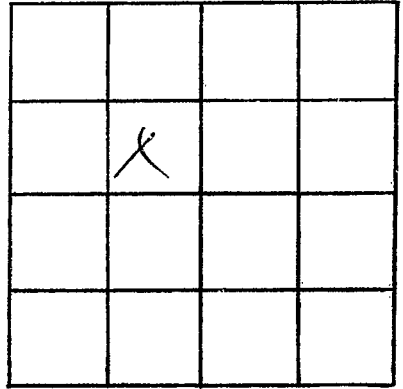

SECTION 17

Please indicate well location X.

ADDITIONAL INFORMATION

If more than one screen,
show locations of each on sketch.