

Washington  
 F63  
 5-28-81

MISSISSIPPI DEPARTMENT OF NATURAL RESOURCES  
 Bureau of Land and Water Resources  
 Southport Mall  
 P.O. Box 10631  
 Jackson, Mississippi 39209  
 WATER WELL DRILLERS LOG

CODED

May 28 1981 date well completed  
 Larry's Well's pump firm name  
 Washington county well located

LANDOWNER: <u>George Rice</u>	description of formations encountered	from	to
<u>Indianola MS.</u> (mailing address)	<u>Clay</u> <u>fine sand</u> <u>Med to coarse sand</u>	<u>0</u> <u>31</u> <u>54</u>	<u>31</u> <u>54</u> <u>115</u>
WELL LOCATION: sec. <u>29</u> T <u>18</u> N R. <u>6</u> W <u>4</u> miles <u>E</u> of <u>Jelani</u> (distance) (direction) (nearest town)			
WELL PURPOSE: (home, irrigation, municipal, industrial)			
WELL COMPLETION DATA:			
(1) diameter (inches) <u>12"</u>			
(2) total depth (feet) <u>115'</u>			
(3) static water level (feet) <u>21</u> below above top of ground.			
(4) casing <u>Steel</u> , <u>75'</u> (material) (depth) <u>12"</u> (size) if telescope see back.			
(5) screen <u>40'</u> , <u>75'</u> (length) (depth to top)			
(6) pump <u>12"</u> , <u>Steel</u> (size) (material)			
(6) pump <u>40</u> , <u>2000</u> (HP) (yield gpm)			
(type power)			
(7) electric log <u>No</u> (yes or no)			
(organization running log)			
(8) how well bottom plugged <u>Steel</u> <u>Plate</u>			
DRILLERS REMARKS:			

CODED


DEPT. OF NATURAL RESOURCES  
 BUREAU OF LAND & WATER RESOURCES

OCT 15 1981

RECEIVED

If well telescopes please sketch and show depths.

GROUND LEVEL

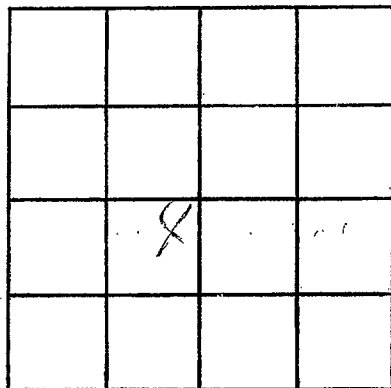

SECTION 29

Please indicate well location X.

ADDITIONAL INFORMATION

If more than one screen,  
show locations of each on sketch.