

Washington  
F 64  
5-29-81

MISSISSIPPI DEPARTMENT OF NATURAL RESOURCES  
Bureau of Land and Water Resources  
Southport Mall  
P.O. Box 10631  
Jackson, Mississippi 39209  
WATER WELL DRILLERS LOG

CODED

May 29 1981 Larry's Well & pump Washington  
date well completed firm name county well located

LANDOWNER: <u>George Rice</u>	description of formations encountered	from	to
<u>Indianola, Ms.</u> (mailing address)	<u>Clay</u>	<u>0</u>	<u>30</u>
WELL LOCATION: sec <u>19</u> T <u>18</u> N R <u>6</u> E <u>4</u> miles <u>E</u> of <u>Jehud</u> (distance) (direction) (nearest town)	<u>Fine Sand</u>	<u>30</u>	<u>50</u>
WELL PURPOSE: (home, irrigation, municipal, industrial)	<u>Med to Coarse</u>	<u>50</u>	<u>100</u>
WELL COMPLETION DATA:	CODED		
(1) diameter (inches) <u>16"</u>			
(2) total depth (feet) <u>100'</u>			
(3) static water level (feet) <u>20</u> <del>above</del> below top of ground.			
(4) casing <u>Steel</u> , <u>60'</u> (material) (depth)			
_____ if telescope see back. (size)			
(5) screen <u>40'</u> , <u>60'</u> (length) (depth to top)			
<u>16"</u> , <u>Steel</u> (size) (material)			
(6) pump <u>60</u> <u>3000</u> (HP) (yield gpm)			
_____ (type power)			
(7) electric log <u>NO</u> (yes or no)			
_____ (organization running log)			
(8) how well bottom plugged <u>Steel</u> <u>Plate</u>			
DRILLERS REMARKS:			


DEPT. OF NATURAL RESOURCES  
BUREAU OF LAND & WATER RESOURCES

OCT 15 1981

RECEIVED

If well telescopes please sketch and show depths.

GROUND LEVEL

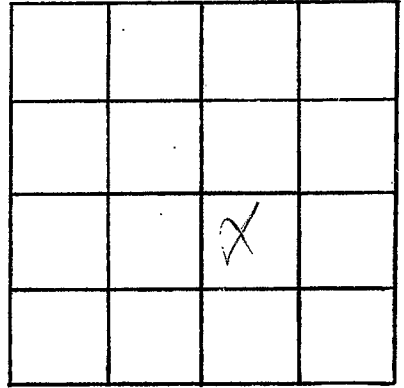

SECTION

*29*

Please indicate well location X.

ADDITIONAL INFORMATION

If more than one screen,  
show locations of each on sketch.