

MISSISSIPPI DEPARTMENT OF NATURAL RESOURCES

Bureau of Land and Water Resources

Southport Mall

P.O. Box 10631

Jackson, Mississippi 39209

WATER WELL DRILLERS LOG

CODED

WASHINGTON
 CL-1813
F 97
6-17-81

6-17 19 81 LAYNE CENTRAL CO. WASHINGTON
 date well completed firm name county well located

LANDOWNER:
 LIPE FARMS
 RT. 2, Indianola, MS
 (mailing address)

description of formations encountered	from	to
clay	0	8
brown sand	8	23
fine sand	23	46
coarse sand	46	55
c. sand - pea gravel	55	67
c. sand - gravel	67	95
c. sand - big gravel	95	100
fine sand	100	120

WELL LOCATION:
 sec. 36 T. 18 N R. 6 E
2 miles NE of TRIBETT
 (distance) (direction) (nearest town)

WELL PURPOSE: irrigation
 (home, irrigation, municipal, industrial)

WELL COMPLETION DATA:

(1) diameter (inches) 32"
 (2) total depth (feet) 119' 3"
 (3) static water level (feet) 24' below above top of ground.
 (4) casing steel 60'
 (material) (depth)
16"
 (size) if telescope see back.
 (5) screen 40' 60'
 (length) (depth to top)
16" st. steel
 (size) (material)
 (6) pump 60 2500
 (HP) (yield gpm)
DIESEL
 (type power)
 (7) electric log no
 (yes or no)
 (organization running log)
 (8) how well bottom plugged

CODED

DEPT. OF NATURAL RESOURCES
 BUREAU OF LAND & WATER RESOURCES


OCT 20 1981

RECEIVED

DRILLERS REMARKS:

If well telescopes please sketch and show depths.

GROUND LEVEL

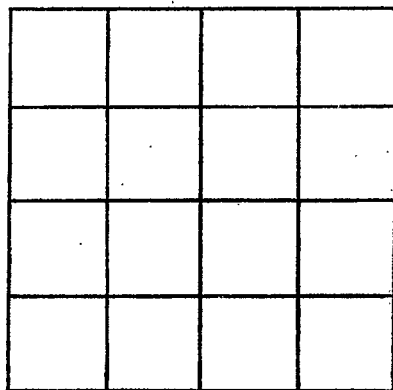

SECTION _____

Please indicate well location X.

ADDITIONAL INFORMATION

If more than one screen, show locations of each on sketch.