

F99
 WASHINGTON
 8-4-83

MISSISSIPPI
 BOARD OF WATER COMMISSIONERS
 416 North State Street
 Jackson, Mississippi 39201

CODED

WATER WELL DRILLERS LOG

8-4 1983 Schultz Drilling Washington
 date well completed firm name county well located

LANDOWNER:	description of formations encountered	from	to
GUS PIERALISI			
Leland MS (mailing address)	clay	0	20
	COARSE SAND	20	60
	COARSE SAND + GRAVEL	60	105
WELL LOCATION: sec 34 T 19 S R 6 E 5 miles NE of Leland (distance) (direction) (nearest town)			
WELL PURPOSE: <u>irrigation</u> (home, irrigation, municipal, industrial)			
WELL COMPLETION DATA:			
(1) diameter (inches) <u>16"</u>			
(2) total depth (feet) <u>105'</u>			
(3) static water level (feet) <u>22'</u> below top of ground.			
(4) casing <u>PVC</u> <u>55'</u> (material) (depth)			
<u>16'</u> if telescope see back. (size)			
(5) screen <u>50'</u> <u>55'</u> (length) (depth to top)			
<u>16"</u> <u>PVC</u> (size) (material)			
(6) pump <u>60</u> <u>4000</u> (HP) (yield gpm)			
<u>pto - Diesel</u> (type power)			
(7) electric log <u>NO</u> (yes or no)			
<u>X</u> (organization running log)			
(8) how well bottom plugged <u>PVC CAP</u>			

CODED

DEPT. OF NATURAL RESOURCES
 BUREAU OF LAND & WATER RESOURCES


AUG 11 1983

RECEIVED

DRILLERS REMARKS:

If well telescopes please sketch and show depths.

GROUND LEVEL

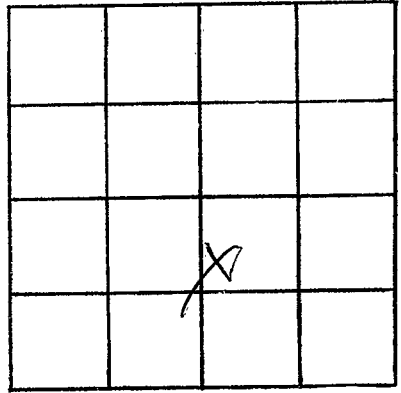

SECTION 84

Please indicate well location X.

ADDITIONAL INFORMATION

If more than one screen, show locations of each on sketch.