

F 101
 Washington
 CL-2515
 7-27-83

MISSISSIPPI DEPARTMENT OF NATURAL RESOURCES
 Bureau of Land and Water Resources
 Southport Mall
 P.O. Box 10631
 Jackson, Mississippi 39209
WATER WELL DRILLERS' LOG

CODED

7-27 19 83 LAYNE CENTRAL CO. WASHINGTON
 date well completed firm name county well located

LANDOWNER:
 RAY BECKHAM
 RT. 2, Box 133
 Ieland, MS 38756
 (mailing address)

description of formations encountered	from	to
	clay	0
silt	8	32
coarse sand	32	52
coarse sand pea gravel	52	92
gravel	92	115
sand	115	117

WELL LOCATION:
 sec. 6 T 18 N R 6 E
 5 miles NE of LELAND
 (distance) (direction) (nearest town)

SET at 114'

WELL PURPOSE:
 (home, irrigation, municipal, industrial)

WELL COMPLETION DATA:

- (1) diameter (inches) 32"
- (2) total depth (feet) 118'
- (3) static water level (feet) 19' below top of ground.
- (4) casing steel 64' (material), (depth), 16" (size) if telescope see back.
- (5) screen 50' 64' (length), (depth to top), 16" steel (size), (material)
- (6) pump 80 1000 (HP), (yield gpm), diesel (type power)
- (7) electric log no (yes or no), (organization running log)
- (8) how well bottom plugged st. plate

DRILLERS REMARKS:


DEPT. OF NATURAL RESOURCES
 BUREAU OF LAND & WATER RESOURCES

OCT 10 1983

RECEIVED

If well telescopes please sketch and show depths.

GROUND LEVEL

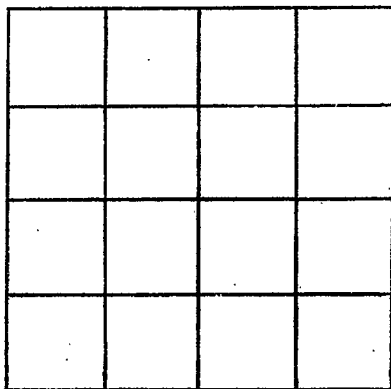

SECTION _____

Please indicate well location X.

ADDITIONAL INFORMATION

If more than one screen,
show locations of each on sketch.