

MISSISSIPPI DEPARTMENT OF NATURAL RESOURCES

Bureau of Land and Water Resources

Southport Mall

P.O. Box 10631

Jackson, Mississippi 39209

WATER WELL DRILLERS LOG

CODED

WASHINGTON  
F102  
3-1-86

3-1 1986 date well completed Schultz Drilling firm name Washington county well located

LANDOWNER: PHSO CORP.  
Rt. 1 Box 176  
Leland MS  
(mailing address)

description of formations encountered	from	to
CLAY	0	25
SAND	25	50
COARSE SAND + PEA GRAVEL	50	100

WELL LOCATION:  
sec. 1 T 18 N R. 6 E  
S W  
1 miles NE of LELAND  
(distance) (direction) (nearest town)

WELL PURPOSE: IRRIGATION  
(home, irrigation, municipal, industrial)

- WELL COMPLETION DATA:
- (1) diameter (inches) 10"
  - (2) total depth (feet) 100'
  - (3) static water level (feet) 24' below top of ground.
  - (4) casing PVC 80'  
(material) (depth)
  - (size) if telescope see back.
  - (5) screen 20' 80'  
(length) (depth to top)
  - 10" PVC  
(size) (material)
  - (6) pump 20 1000  
(HP) (yield gpm)
  - ele  
(type power)
  - (7) electric log no  
(yes or no)
  - x  
(organization running log)
  - (8) how well bottom plugged CAP


DRILLERS REMARKS:  
Permit  
86044 DCP 02

RECEIVED  
MAR 18 1986

Department of Natural Resources  
Bureau of Land & Water Resources

If well telescopes please sketch and show depths.

GROUND LEVEL

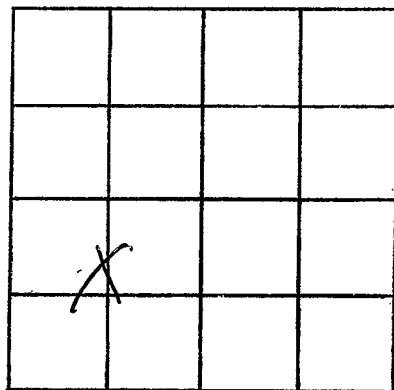

SECTION 1

Please indicate well location X.

ADDITIONAL INFORMATION

If more than one screen, show locations of each on sketch.