

Bureau of Land and Water Resources

COUNTY WELL LOCATED	
Washington	
WELL NUMBER	CODED
2 F113	
DATE WELL COMPLETED	
5-11-89	

PERMIT NUMBER

NAME OF DRILLING FIRM

NAME OF DRILLING FIRM
IRRIGATION EQUIPMENT

601/887-2555

INDIANOLA, MS

C O D E D

P.O. Box 10631

Jackson, Mississippi 39209

WATER WELL DRILLERS LOG

NAME & MAILING ADDRESS OF LANDOWNER:

PUMP DATA

PUMP TYPE (Circle One):

Submersible, Turbine, Jet Flowing Well,
Other (Describe)

POWER TYPE (Circle One):

Electric, Tractor, Diesel, Gasoline, Butane,
Other (Describe) H/P 75

Pump Capacity (GPM)

No. of Stages

Setting Depth

1200

3

(50)

FT

PUMP TEST

Well yielded _____ GPM with

a drawdown of _____ ft.

after _____ hours of pumping

WELL DATA

Well Depth 105'	Casing Diameter (In.) 16	Casing Length (Ft.) 65'
Type of Casing steel	Hole Depth 105'	Depth to Static Water Level 274'
TYPE OF COMPLETION: (Circle One or More): <input checked="" type="checkbox"/> Gravel Packed, <input type="checkbox"/> Underreamed, <input type="checkbox"/> Telescoped, <input type="checkbox"/> Natural Development, <input type="checkbox"/> Open Hole, <input type="checkbox"/> Other (Describe) _____		
Top of Lap Pipe or Reduction in Casing <div style="display: flex; justify-content: space-between; align-items: center;"> <div style="border: 1px solid black; padding: 5px;"> FEET </div> <div> IF TELESCOPED OR MORE THAN ONE SCREEN: USE BACK PAGE </div> </div>		

LOG DATA

TYPE OF LOG RUN (Circle One):

TYPE OF LOG RUN (Circle One): No Log Run,
Electric, Gamma Ray, Density, Sonic, Neutron,
Other (Describe)

Name of Organization Running Log

GEOLOGIC DATA (Office Use Only)

Surface Elev.	Geologic Unit	Unit Thickness	Depth to Top
Subs. SWL	Date	Analysis	Aquifer Test

Driller's Remarks

SCREEN DATA


Diameter - Inches 16	Length - Feet 40	Slot Size - Inches .060
Screen Type steel		Depth to Bottom - Feet 105

DESCRIPTION OF FORMATIONS ENCOUNTERED	FROM	TO	FORMATIONS (Continued)	FROM	TO
clay	0	10	RECEIVED		
medium sand	10	45			
COARSE SAND + GRAVEL	45	90			
COARSE SAND + ROCKS	90	100			
medium sand	100	103			
clay	103	105			
			JUN 7 1989		
			Department of Natural Resources Bureau of Land & Water Resources		
			IF MORE SPACE IS NEEDED, USE BACK		

If well telescopes please
sketch and show depths.

IRRIGATION EQUIPMENT
601/887-2555
INDIANOLA, MS

GROUND LEVEL

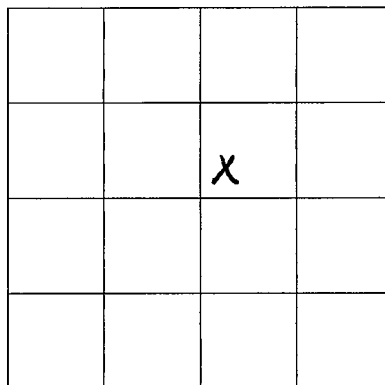

SECTION 21

Please indicate well location X.

ADDITIONAL INFORMATION

If more than one screen,
show location of each on sketch.