

MISSISSIPPI DEPARTMENT OF ENVIRONMENTAL QUALITY
Bureau of Land and Water Resources

P. O. Box 10631
Jackson, MS 39289-0631
WATER WELL DRILLERS LOG

COUNTY WELL LOCATED WASHINGTON	
WELL NUMBER F 114	CODED <input checked="" type="checkbox"/>
DATE WELL COMPLETED 8-21-91	

PERMIT NUMBER
NAME OF DRILLING FIRM Schultz Drilling

NAME & MAILING ADDRESS OF LANDOWNER Zeggoni and Sons Farm			
Hwy 82 East			
Leland MS. 38756			
WELL LOCATION:	SEC	TOWNSHIP	RANGE
	11	18	6
		N	E
		S	W
DISTANCE	DIRECTION	NEAREST TOWN	
5 Miles	East	of Leland	
OTHER LANDMARK			
WELL PURPOSE: <input checked="" type="checkbox"/> Home Irrigation, Municipal, Industrial, Fish Pond, etc.			

PUMP DATA		
PUMP TYPE (Circle One): <input checked="" type="checkbox"/> Submersible Turbine, Jet Flowing Well, Other (Describe) _____		
POWER TYPE (Circle One): <input checked="" type="checkbox"/> Electric Tractor, Diesel, Gasoline, Butane, Other (Describe) _____ H/P 1		
Pump Capacity (GPM) 20	No. of Stages 7	Setting Depth 105 FT.
PUMP TEST		
Well yielded _____ GPM with a drawdown of _____ ft. after _____ hours of pumping		


WELL DATA		
Well Depth 400 ft	Casing Diameter (In.) 4x2	Casing Length (Ft.) 380
Type of Casing pvc	Hole Depth 400	Depth to Static Water Level
TYPE OF COMPLETION: (Circle One or More): <input checked="" type="checkbox"/> Gravel Packed, <input type="checkbox"/> Underreamed, <input type="checkbox"/> Telescoped, <input checked="" type="checkbox"/> Natural Development, <input type="checkbox"/> Open Hole, <input type="checkbox"/> Other (Describe) Hole plug		
Top of Lap Pipe or Reduction in Casing		
FEET	IF TELESCOPED OR MORE THAN ONE SCREEN: USE BACK PAGE	

LOG DATA	
TYPE OF LOG RUN (Circle One): <input checked="" type="checkbox"/> No Log Run, Electric, Gamma Ray, Density, Sonic, Neutron, Other (Describe) _____	
Name of Organization Running Log	

SCREEN DATA		
Diameter - Inches 2	Length - Feet 20	Slot Size - Inches .010
Screen Type pvc	Depth to Bottom - Feet 400	


GEOLOGIC DATA (Office Use Only)			
Surface Elev.	Geologic Unit	Unit Thickness	Depth to Top
Subs. SWL	Date	Analysis	Aquifer Test
Driller's Remarks			

DESCRIPTION OF FORMATIONS ENCOUNTERED	FROM	TO
Top soil	0	14
sand + gravel	14	140
clay	140	200
Sand & clay streaks	200	320
sand	320	400

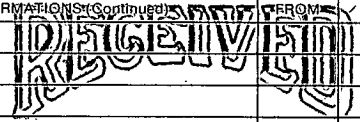FORMATIONS (Continued)		FROM	TO
			
DEC 06 1991			
Dept. of Environmental Quality Bureau of Land & Water Resources			
IF MORE SPACE IS NEEDED, USE BACK			

If well telescopes please sketch and show depths.

GROUND LEVEL

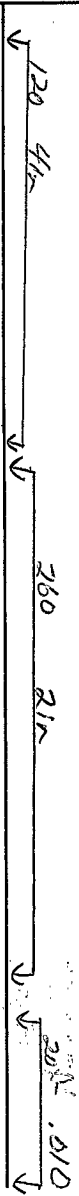

			X

SECTION 11

Please indicate well location X.

ADDITIONAL INFORMATION

If more than one screen, show location of each on sketch.