



If well telescopes please sketch and show depths.


GROUND LEVEL

140 4"

370 2"

390 2" scv.

If more than one screen,  
show location of each on sketch.

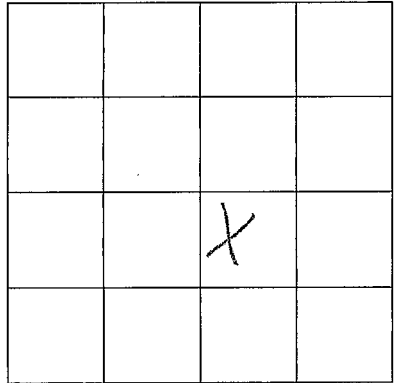

SECTION 10

Please indicate well location X.

ADDITIONAL INFORMATION

23  
20