

Holly Ridge

MISSISSIPPI DEPARTMENT OF ENVIRONMENTAL QUALITY  
Office of Land and Water Resources

P. O. Box 10631  
Jackson, MS 39289-0631  
WATER WELL DRILLERS LOG

COUNTY WELL LOCATED  
Washington  
WELL NUMBER F123 CODED  
DATE WELL COMPLETED  
6-10-98

PERMIT NUMBER  
NAME OF DRILLING FIRM  
Schudco Ltd.

NAME & MAILING ADDRESS OF LANDOWNER  
Fratesi Farms.  
Rt 2 Box 312  
Leland MS 38756  
WELL LOCATION: SEC 17 TOWNSHIP 18 RANGE 6  
DISTANCE 2 1/2 Miles East of Leland  
OTHER LANDMARK  
WELL PURPOSE:  Home Irrigation, Municipal, Industrial, Fish Pond, etc.

PUMP DATA  
PUMP TYPE (Circle One):  
 Submersible Turbine, Jet, Flowing Well,  
Other (Describe) \_\_\_\_\_  
POWER TYPE (Circle One):  
 Electric Tractor, Diesel, Gasoline, Butane,  
Other (Describe) Replacement H/P Well  
Pump Capacity (GPM) \_\_\_\_\_ No. of Stages \_\_\_\_\_ Setting Depth \_\_\_\_\_ FT.  
PUMP TEST  
Well yielded \_\_\_\_\_ GPM with  
a drawdown of \_\_\_\_\_ ft.  
after \_\_\_\_\_ hours of pumping

WELL DATA  
Well Depth 520 Casing Diameter (In.) 4 X 3 Casing Length (Ft.) 490  
Type of Casing PVC Hole Depth 520 Depth to Static Water Level 34  
TYPE OF COMPLETION: (Circle One or More):  
 Gravel Packed,  Underreamed,  Telescoped,  
 Natural Development,  Open Hole,  Other  
WELL GROUTED TO A DEPTH OF 10 FEET  
Type Grout (circle one): Cement, Bentonite,  Mix

LOG DATA  
TYPE OF LOG RUN (Circle One):  No Log Run,  
Electric, Gamma Ray, Density, Sonic, Neutron,  
Other (Describe) \_\_\_\_\_  
Name of Organization Running Log

SCREEN DATA  
Diameter - Inches 3 Length - Feet 30 ft. Slot Size - Inches .008  
Screen Type PVC Depth to Bottom - Feet 520

GEOLOGIC DATA (Office Use Only)

Surface Elev.	Geologic Unit	Unit Thickness	Depth to Top
Subs. SWL	Date	Analysis	Aquifer Test

Driller's Remarks

Top of Lap Pipe or Reduction in Casing

FEET IF TELESCOPED OR MORE THAN ONE SCREEN: USE BACK PAGE

DESCRIPTION OF FORMATIONS ENCOUNTERED	FROM	TO
Top soil	0	16
sand + gravel	16	155
clay	155	300
sandy clay	300	400
fine sand	400	440
med sand	440	480
Course sand	480	520


FORMATIONS CONTINUED FROM PAGE \_\_\_\_\_  
**RECEIVED**

JUL 02 1997

Dept. of Environmental Quality  
Office of Land & Water Resources

If well telescopes please sketch and show depths.

GROUND LEVEL

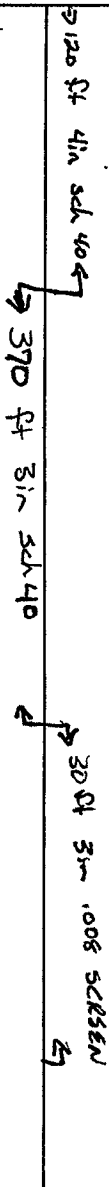

		X	

SECTION 17

Please indicate well location X.

ADDITIONAL INFORMATION

If more than one screen, show location of each on sketch.