

MISSISSIPPI DEPARTMENT OF ENVIRONMENTAL QUALITY

Office of Land and Water Resources

P. O. Box 10631

Jackson, MS 39289-0631

WATER WELL DRILLERS LOG

COUNTY WELL LOCATED
Washington

WELL NUMBER
F-126

CODED

DATE WELL COMPLETED
1/14/02

PERMIT NUMBER

NAME OF DRILLING FIRM
Chicot Irrigation

NAME & MAILING ADDRESS OF LANDOWNER
SID KAHN

**1279 PHINESEE RD.
GREENVILLE MS. 38701**

Latitude: **33 25 21 46"**

Longitude: **090 51 00**

WELL LOCATION: SEC **8** TOWNSHIP **18 N** RANGE **6 E**

DISTANCE **3.1** Miles DIRECTION **North** of NEAREST TOWN **Leland**

OTHER LANDMARK
old Elevator on Rexburg Rd

WELL PURPOSE: Home Irrigation Municipal, Industrial, Fish Pond, etc.

PUMP DATA

PUMP TYPE (Circle One):
 Submersible Turbine, Jet, Flowing Well,
Other (Describe)

POWER TYPE (Circle One):
 Electric Tractor, Diesel, Gasoline, Butane,
Other (Describe) **H/P 15**

DESCRIPTION OF FORMATIONS ENCOUNTERED	FROM	TO
Top Soil	0	10
Gray Clay	10	40
Fine Sand	40	80
Coarse Sand	80	110
Gravel	110	113

RECEIVED
FEB 13 2003
BY: OLWR

Top of Lap Pipe or Reduction in Casing

FEET IF TELESCOPED OR MORE THAN ONE SCREEN: USE BACK PAGE

WELL DATA

Well Depth 110	Casing Diameter (In.) 10	Casing Length (Ft.) 80
Type of Casing PVC	Hole Depth 113	Depth to Static Water Level 26

TYPE OF COMPLETION: (Circle One or More):
 Gravel Packed, Underreamed, Telescoped,
 Natural Development, Open Hole, Other
(Describe)

WELL GROUTED TO A DEPTH OF _____ FEET

Type Grout (circle one): Cement, Bentonite, or Mix

SCREEN DATA

Diameter - Inches 10	Length - Feet 30	Slot Size - Inches 051
Screen Type PVC	Depth to Bottom - Feet 110	

I certify that the well was drilled, constructed and completed in accordance with all applicable Requirements of the Mississippi Department of Environmental Quality and/or the Mississippi Department of Health regulations and state laws.


James McDonald
Signature of Licensed Driller and License No.
332

2/9/03
Date

Additional Information Required On Back

If well telescopes please sketch and show depths.

GROUND LEVEL

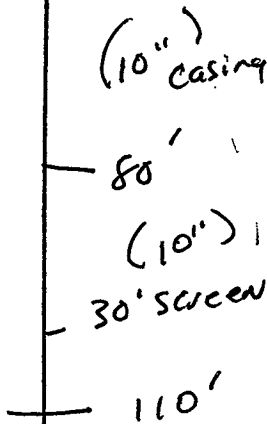

	7.		

SECTION 7

Please indicate well location X.

Pump Capacity (GPM)	No. of Stages	Setting Depth
800	1	60 FT.

PUMP TEST

Well yielded _____ GPM with
a drawdown of _____ ft.
after _____ hours of pumping

LOG DATA

TYPE OF LOG RUN (Circle One): No-Log-Run,
Electric, Gamma Ray, Density, Sonic, Neutron,
Other (Describe) _____

Name of Organization Running Log _____

GEOLOGIC DATA (Office Use Only)

Surface Elev.	Geologic Unit	Unit Thickness	Depth to Top
Subs. SWL	Date	Analysis	Aquifer Test

Driller's Remarks

If more than one screen,
show location of each on sketch.