| State W   | ell Report   |  |  |
|---|--|--|--|
| , , ,   | For Office Use Only:                                   |  |  |
| County:   | t of Environmental Quality Aquifer:                    |  |  |
| lerrigation bosis smantl  | nd Water Resources Well #: F-140                       |  |  |
| Driller I .O. D   | OX 10631   |  |  |
|   | IS 39289-0631 L. S. Elevation:                         |  |  |
| (601)354  | 1-6938 (fax) E-log #:                                  |  |  |
| State Law requires that this report be prepared by the driller in detail and filed with the Department within 30 days of completion of drilling of the well.            |  |  |  |
| Well Owner Information  | Well Location  |  |  |
| Owner Name St. Rest Plantation  | Latitude: 33, 24 ,77N , Longitude: 90,46 01W ,         |  |  |
| Mailing Address: 65 Holly Ridge Road  | Method of Lat/Long (circle one): Conventional Survey,  |  |  |
|   | USGS quad, Hand-held GPS, Survey-grade GPS             |  |  |
| Tu 21 1 1 20 20754  | NE 1/4 NE 1/4 Sec 13 Twn 18N Rng 6W                    |  |  |
| Indianola, MS 38751   |  |  |  |
| City State Zip Code   | Distance Direction Nearest Town 7 Miles East of Leland |  |  |
| Telephone No. (662-887-3821   |  |  |  |
| Well I  | Data Johnson Place                                     |  |  |
| weii T  | - Replacement  |  |  |
| Purpose of Well (circle one) Home Industrial Public Supply Irrigation Fish Culture Other)   |  |  |  |
| Date well drilling started: 11-23-05 Date well drilling completed: 11-23-05   |  |  |  |
| If flowing, method of flow regulation: Valve Other (describe)   |  |  |  |
| Static Water Level: 24' feet above or below (circle one) la   | and surface Date measured: 11-30-05                    |  |  |
| Method of Measurement (circle one) steel tape electric tape air line other:   |  |  |  |
| Hole depth: 126' Well depth: 126' Well grouted to a depth of 10 feet  |  |  |  |
| Type of grout (circle one): Cement Bentonne Mix   |  |  |  |
| Casing length: 86 feet Casing diameter: 16 inches Type of casing: PVC Sch. 40   |  |  |  |
| Screen length: 40 feet Screen diameter: 16  | _inches Type of screen: _PVC Sch. 40                   |  |  |
| Screen slot size:   | 87 feet to 126 feet                                    |  |  |
| Type of completion (circle all applicable): Gravel packed Underreamed Telescoped Open hole Natural Development  |  |  |  |
| Other (describe):   |  |  |  |
| Top of lap pipe or reduction in casing: feet. If telescoped or more than one screen, describe on back of page   |  |  |  |
| Logs run (circle all applicable). No log run Electric Gamma Ray Density Sonic Neutron Other:  |  |  |  |
| Name of organization running log(s):  I certify that the well was drilled, constructed, and completed in accordance with all applicable requirements of the Mississippi |  |  |  |
| Department of Environmental Quality and/or the Mississippi Department of Health regulations and state laws.   |  |  |  |

Irrigation Equipment Inc. Patrick M. Chism 0695

Print Name of Water Well Contractor and License No.

RECEIVED

Signature of Water Well Contractor

OEC 10 2005

BY: OLWR




If well telescopes please sketch below and show depths.

Ground Level

| Description of Forma         | ntions Encountered                    | From | To                                      |
|------------------------------|---------------------------------------|------|---|
| Clay                         |                                       | U    | 28                                      |
| Fine Sand                    |                                       | 29   | 35                                      |
| Fine Sand/gi                 | ravel                                 | 36   | 45                                      |
| Fine Sand/gi<br>Med. Sand/gi | ravel                                 | 46_  | 126                                     |
|                              |                                       |      |   |
|                              |                                       |      |   |
|                              |                                       | 1    |   |
|                              |                                       |      |   |
|                              | · · · · · · · · · · · · · · · · · · · |      |   |
|                              |                                       |      |   |
|                              |                                       |      |   |
|                              |                                       | ľ    |   |
|                              |                                       |      |   |
|                              | <u> </u>                              |      |   |
|                              |                                       |      | $\dagger$                               |
|                              |                                       |      |   |
|                              |                                       |      | لــــــــــــــــــــــــــــــــــــــ |

If more than one screen, show location of each on sketch

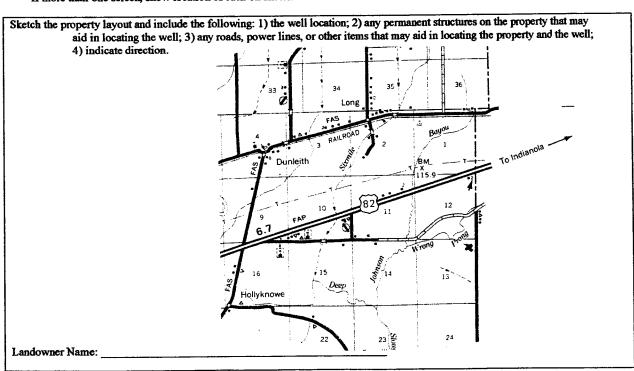

Signature of Water Well Contractor

## STATE WELL REPORT

## Part 2

washington County: Permit#: Irrigation Equipment Driller:

Pump Installer's Completion Report Mississippi Department of Environmental Quality Office of Land and Water Resources Inc. P.O. Box 10631 Jackson, MS 39289-0631

For Office Use Only: Aquifer:

| Date completed: 11-30-05   |                             | 1)961-5210<br>854-6938 (fax) Elevation:                         |
|--|-----------------------------|---|
| This report should be prepared by the pump installer in detail and filed with the Department within 30 days of the installation of pump. |                             |   |
| Well Owner Informati   |                             | Well Location   |
| Owner Name: St.Rest Plantat  | tion                        | Latitude: Longitude:  |
| Mailing Address: 65 Holly R  | •                           | Method of Lat/Long (circle one): Conventional Survey,           |
| Indianola  City State  662-887-3827  | Zip Code                    | USGS quad, Hand-held GPS, Survey-grade GPS                      |
| Pump Type<br>Circle one  |                             | Power Type Circle one   |
| Air Lift Jet   | Submersible                 | Diesel Engine Gasoline Engine Natural Gas                       |
| Bucket Piston  | Turbine                     | Electric Motor Hand Tractor PTO                                 |
| Centrifugal Rotary   | Flowing Well                | Windmill Other (specify):                                       |
| Other (specify):   |                             | Horse Power Rating of Motor: 60                                 |
| Date Pump Installed: 11-30-05  |                             | Setting Depth: 70 feet  |
| Rated Pump Capacity: 2500-3000   |                             | Number of Stages:1  |
| Pump Test Data   |                             | Method of Measuring Water Level Circle one                      |
| Date Well Tested:  Static Water Level (A):  Pumping Water Level (B):  Feet Below Land Surface  |                             | Air Line Electric Measuring Line Steel Tape Other (specify):    |
| Drawdown [(B) - (A)]:Feet I  | Selow Land Surface          | For flowing well, measured shut in head:feet                    |
| Test Pumping Rate:  Duration of Pump Test (minimum 4 hours):   |                             | Well yielded GPM with a drawdown of feet after hours of pumping |
| I HEREBY CERTIFY that the above statements   | ents are true to the best o | of my knowledge/  |

Print Name of Pump Installer and License No. (if applicable) Signature of Pump Installer

RECEIVED

BYJULWR