

State Well Report

Part 1

Mississippi Department of Environmental Quality
Office of Land and Water Resources
P.O. Box 10631
Jackson, MS 39289-0631
(601)961-5210
(601)354-6938 (fax)

County: Washington
Permit #: GW41524
Irrigation Equipment
Driller: _____
Date drilling completed: 2-19-07

For Office Use Only:
Aquifer: _____
Well #: F-151
L. S. Elevation: _____
E-log #: _____

State Law requires that this report be prepared by the driller in detail and filed with the Department within 30 days of completion of drilling of the well.

Well Owner Information	Well Location
Owner Name <u>Holly Ridge Planting</u>	Latitude: <u>33 24 59.3N</u> Longitude: <u>90 47 25.6W</u>
Mailing Address: <u>65 Holly Ridge Road</u>	Method of Lat/Long (circle one): <u>39</u> Conventional Survey, <u>25</u>
<u>Indianola</u> MS <u>38751</u>	USGS quad, Hand-held GPS, Survey-grade GPS
City State Zip Code	NW $\frac{1}{4}$ NE $\frac{1}{4}$ Sec <u>14</u> Twn <u>18N</u> Rng <u>6W</u>
Telephone No. () _____	Distance Direction Nearest Town
	<u>6</u> Miles <u>East</u> of <u>Leland</u>

Well Data

Purpose of Well (circle one) Home Industrial Public Supply Irrigation Fish Culture Other: _____

Date well drilling started: 2-19-07 Date well drilling completed: 2-19-07

If flowing, method of flow regulation: Valve _____ Other (describe) _____

Static Water Level: 24' feet above or below (circle one) land surface Date measured: 2-21-07

Method of Measurement (circle one) steel tape electric tape air line other: _____

Hole depth: 125 Well depth: 125 Well grouted to a depth of 10 feet

Type of grout (circle one): Cement Bentonite Mix

Casing length: 85 feet Casing diameter: 10 inches Type of casing: PVC 160

Screen length: 40 feet Screen diameter: 10 inches Type of screen: PVC 160

Screen slot size: .050 inches Setting depth: From 86 feet to 125 feet

Type of completion (circle all applicable): Gravel packed Underreamed Telescoped Open hole Natural Development

Other (describe): _____


Top of lap pipe or reduction in casing: _____ feet. If telescoped or more than one screen, describe on back of page

Logs run (circle all applicable): No log run Electric Gamma Ray Density Sonic Neutron Other: _____

Name of organization running log(s): _____

I certify that the well was drilled, constructed, and completed in accordance with all applicable requirements of the Mississippi Department of Environmental Quality and/or the Mississippi Department of Health regulations and state laws.

Irrigation Equipment Inc.
Patrick M. Chism 0695

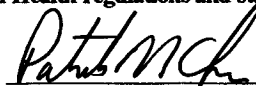

Print Name of Water Well Contractor and License No.

Signature of Water Well Contractor

RECEIVED

MAR 05 2007

BY: OLWR

STATE WELL REPORT

Part 2

Pump Installer's Completion Report
 Mississippi Department of Environmental Quality
 Office of Land and Water Resources
 P.O. Box 10631
 Jackson, MS 39289-0631
 (601)961-5210
 (601)354-6938 (fax)

County: Washington
 Permit #: _____
 Irrigation Equipment
 Driller: _____
 Date completed: 2-19-07

For Office Use Only:

Aquifer: _____
 Well #: F-151
 Elevation: _____


This report should be prepared by the pump installer in detail and filed with the Department within 30 days of the installation of pump.

Well Owner Information	Well Location
Owner Name: <u>Holly Ridge Planting</u>	Latitude: _____ Longitude: _____
Mailing Address: <u>65 Holly Ridge Road</u>	Method of Lat/Long (circle one): Conventional Survey,
<u>Indianola MS 38751</u>	USGS quad, Hand-held GPS, Survey-grade GPS
City State Zip Code	NW ¼ NE ¼ Sec <u>14</u> Twn <u>18N</u> Rng <u>6W</u>
<u>662-887-3821</u>	Distance Direction Nearest Town
Telephone No. () _____	<u>6</u> Miles <u>East</u> of <u>Leland</u>

Pump Type Circle one	Power Type Circle one
Air Lift Jet <input type="radio"/> Submersible <input checked="" type="radio"/>	Diesel Engine <input type="radio"/> Gasoline Engine <input type="radio"/> Natural Gas <input type="radio"/>
Bucket Piston <input type="radio"/> Turbine <input type="radio"/>	Electric Motor <input checked="" type="radio"/> Hand <input type="radio"/> Tractor PTO <input type="radio"/>
Centrifugal Rotary <input type="radio"/> Flowing Well <input type="radio"/>	Windmill <input type="radio"/> Other (specify): _____
Other (specify): _____	Horse Power Rating of Motor: <u>15</u>
Date Pump Installed: <u>2-21-07</u>	Setting Depth: <u>70</u> feet
Rated Pump Capacity: <u>750</u> Gallons Per Minute	Number of Stages: <u>1</u>

Pump Test Data	Method of Measuring Water Level Circle one
Date Well Tested: _____	Air Line <input type="radio"/> Electric Measuring Line <input type="radio"/> Steel Tape <input type="radio"/>
Static Water Level (A): _____ Feet Below Land Surface	Other (specify): _____
Pumping Water Level (B): _____ Feet Below Land Surface	For flowing well, measured shut in head: _____ feet
Drawdown [(B) - (A)]: _____ Feet Below Land Surface	Well yielded _____ GPM with a drawdown of _____ feet after _____ hours of pumping
Test Pumping Rate: _____ Gallons Per Minute	
Duration of Pump Test (minimum 4 hours): _____ hours	

I HEREBY CERTIFY that the above statements are true to the best of my knowledge.

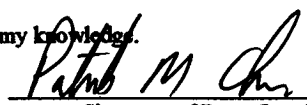Patrick M. Chism 0695 
 Print Name of Pump Installer and License No. (if applicable) Signature of Pump Installer

RECEIVED

MAR 08 2007

BY: OLWF